


T. 4 N. R. 28 E. W. M.

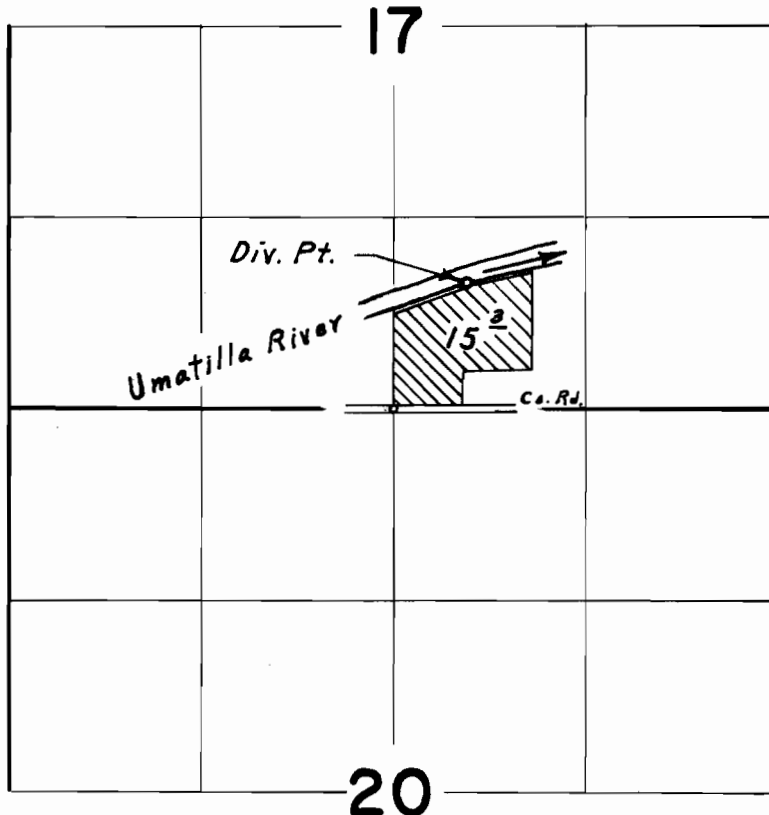

Div. Pt. located 870' N. & 500' E. from S. $\frac{1}{4}$ Corner Section 17

FINAL PROOF SURVEY
UNDER

Application No. 43244. Permit No. 32329.
IN NAME OF

R. M. RALLS

Surveyed June 23, 1971, by L. E. Gould