


T.8S.R.16&17E.W.M.

5

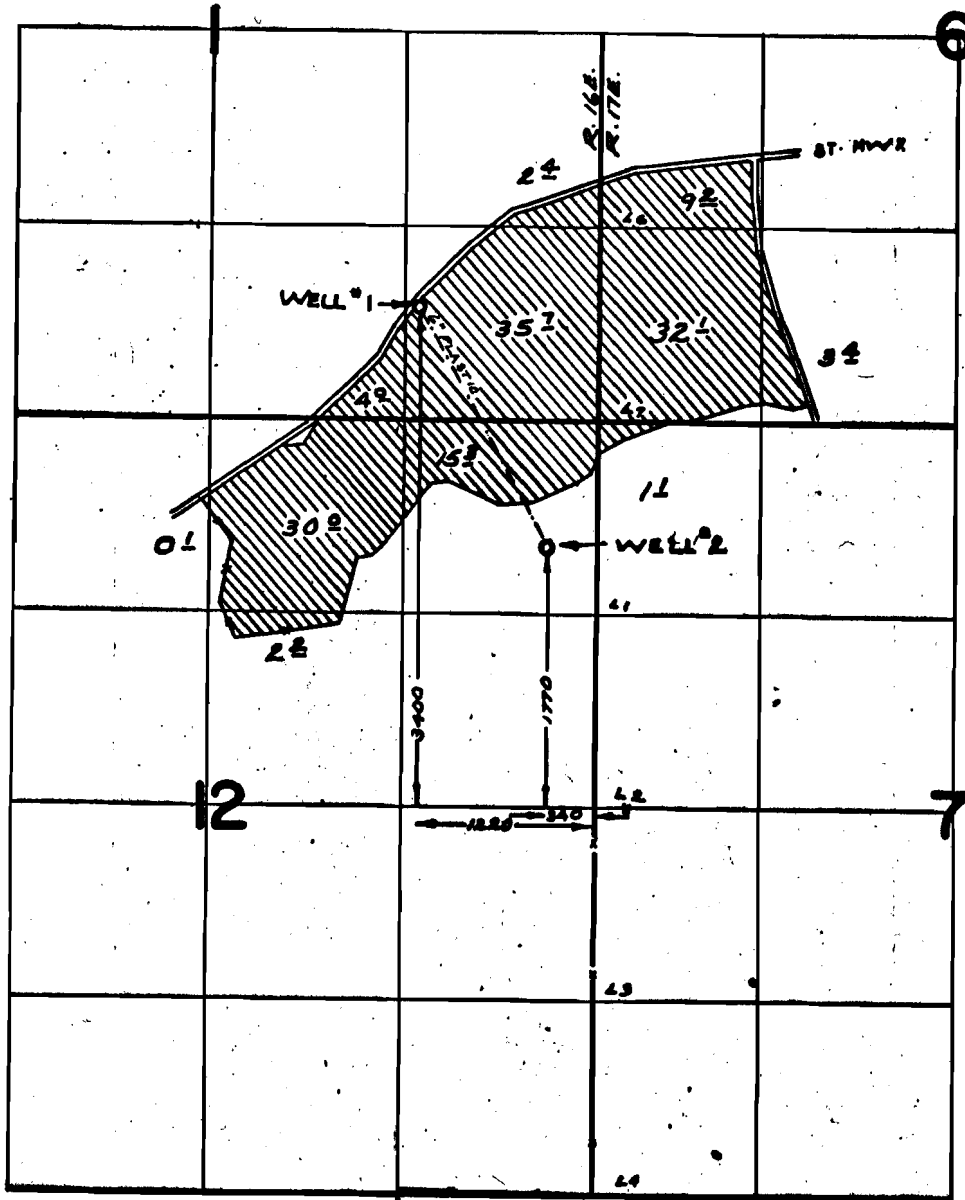

FINAL PROOF SURVEY
UNDER

Application No. G-4312 Permit No. G-4093
IN NAME OF

E. O. BORTHWICK

Surveyed Nov. 29, 1971, by R. MURKIN

page 2
G-4093
1971-P