


31467 5

T.4S.R.13E.W.M.

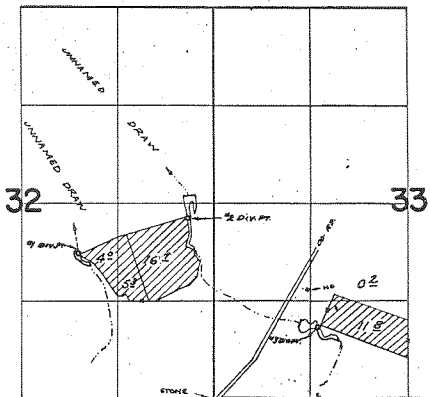

Div. PFS. 144.4' - 150' N.E. 180' W. 52' - 44.0' N. 85' W. 10.3' - 70.0' N. 142.0' E.
ALL FROM S.E. COR. SEC. 32.

FINAL PROOF SURVEY
UNDER

Application No. 42035... Permit No. 31467...
IN NAME OF

JAMES E. PAULSON

Surveyed Jan. 11... 1971... by R. MUCKEN