


T.1N.R.3W.W.M.

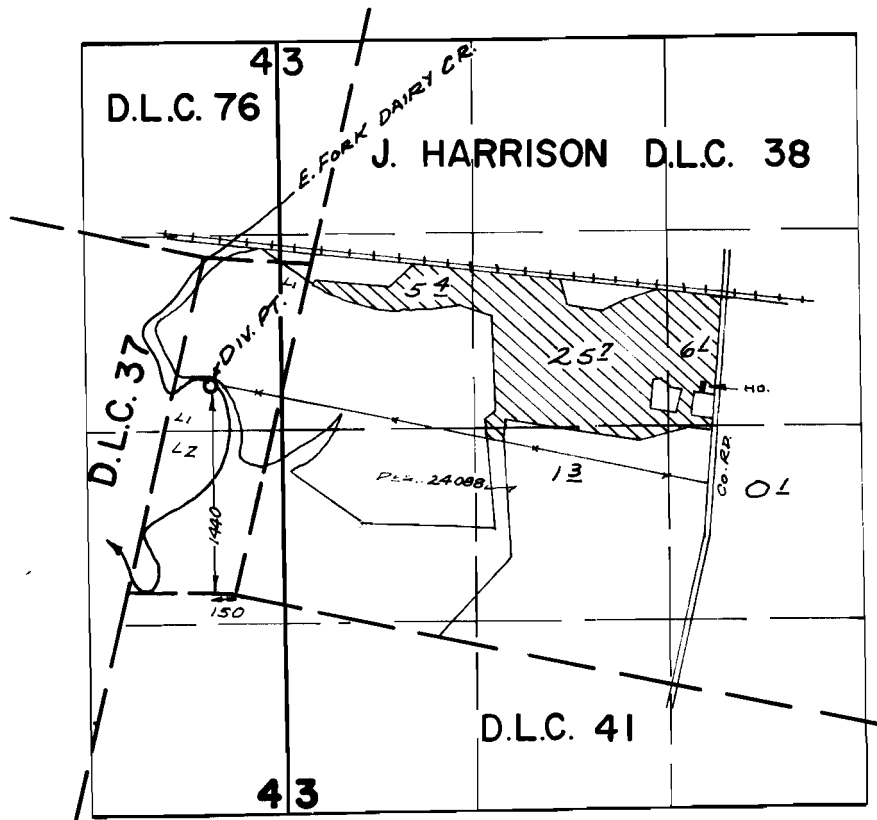

**FINAL PROOF SURVEY**  
UNDER

Application No. 41925 Permit No. 31383  
IN NAME OF

JOSEPH HERTEL

Surveyed APR. 24, 1971, by R. MUCKEN