


T. 2 S. R. 5 W. W. M.

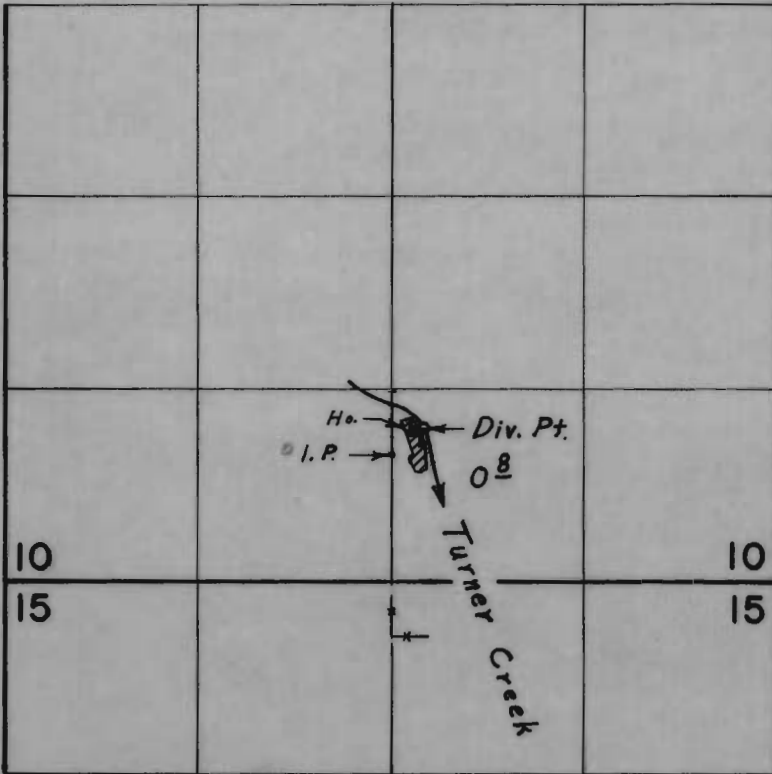

Div. Pt. located 1050' N. & 220' E. from S. $\frac{1}{4}$ Cor. Sec. 10

FINAL PROOF SURVEY
UNDER

Application No. 46761 Permit No. 34723
IN NAME OF

CARL & VIRGINIA HERMINGER

Surveyed June 3, 1971, by L. E. Gould