


T.19 S.R.24&25 E.W.M.

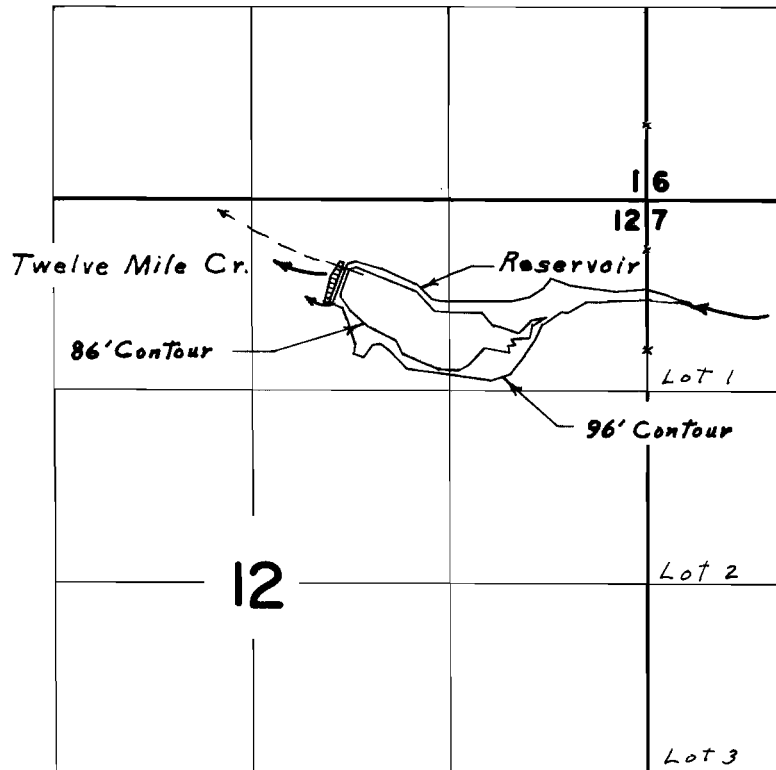

FINAL PROOF SURVEY
UNDER

Application No. R-2223 Permit No. R-869
IN NAME OF

BOSTON RANCH COMPANY

Surveyed Oct. 30, 1968, by L. E. Gould