


T.23S.R.8W.W.M.

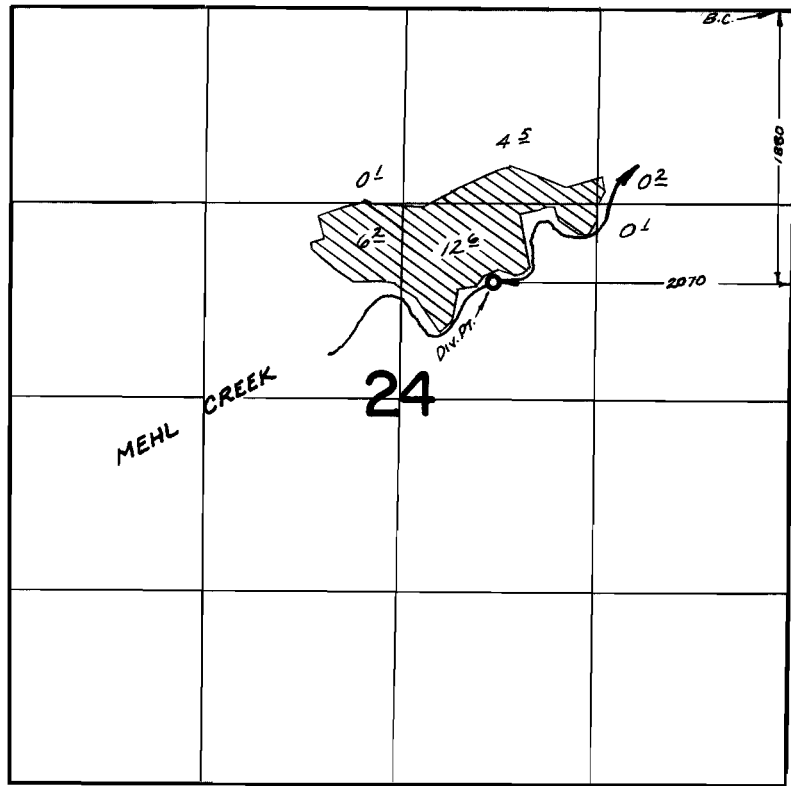

FINAL PROOF SURVEY UNDER

Application No. 40942 Permit No. 30508
IN NAME OF

CHARLES L. ROXIN

Surveyed JUNE 10, 1970, by R. MUCKEN