


T.3S.R.5E.W.M.

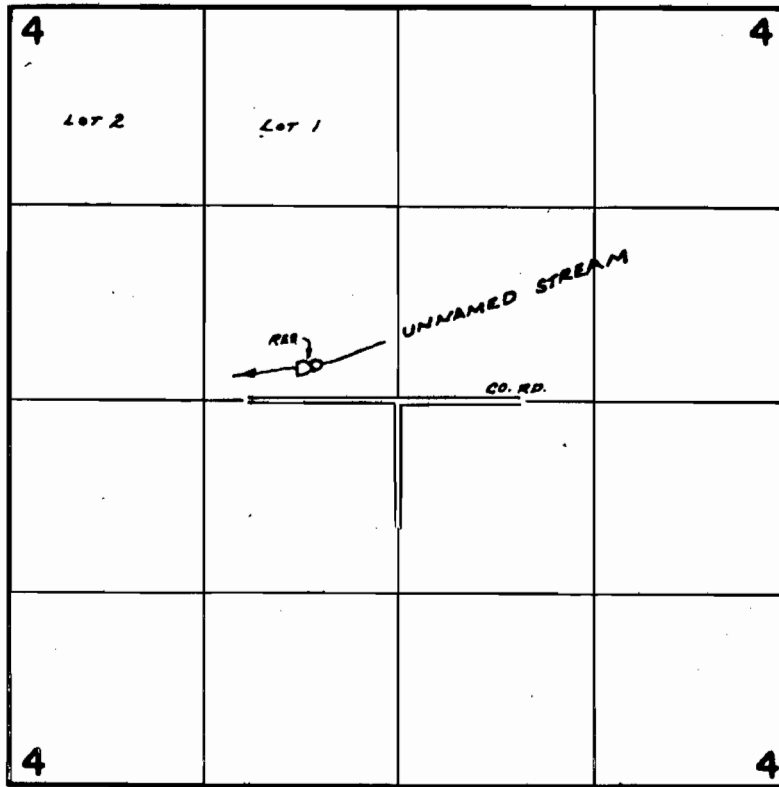

DIV. PT. L&S: 220' N. & 680' W. FROM CEN. SEC. 4

FINAL PROOF SURVEY

UNDER

Application No. R-41432 Permit No. R-4634
41433 30785

IN NAME OF

CLARENCE E. NOBLE

Surveyed Aug. 21, 1970, by R. MUCKEN