


R.23 E.W.M.

R.24 E.W.M.

T.19S.

T.20S.

CROOK COUNTY
HARNEY COUNTY

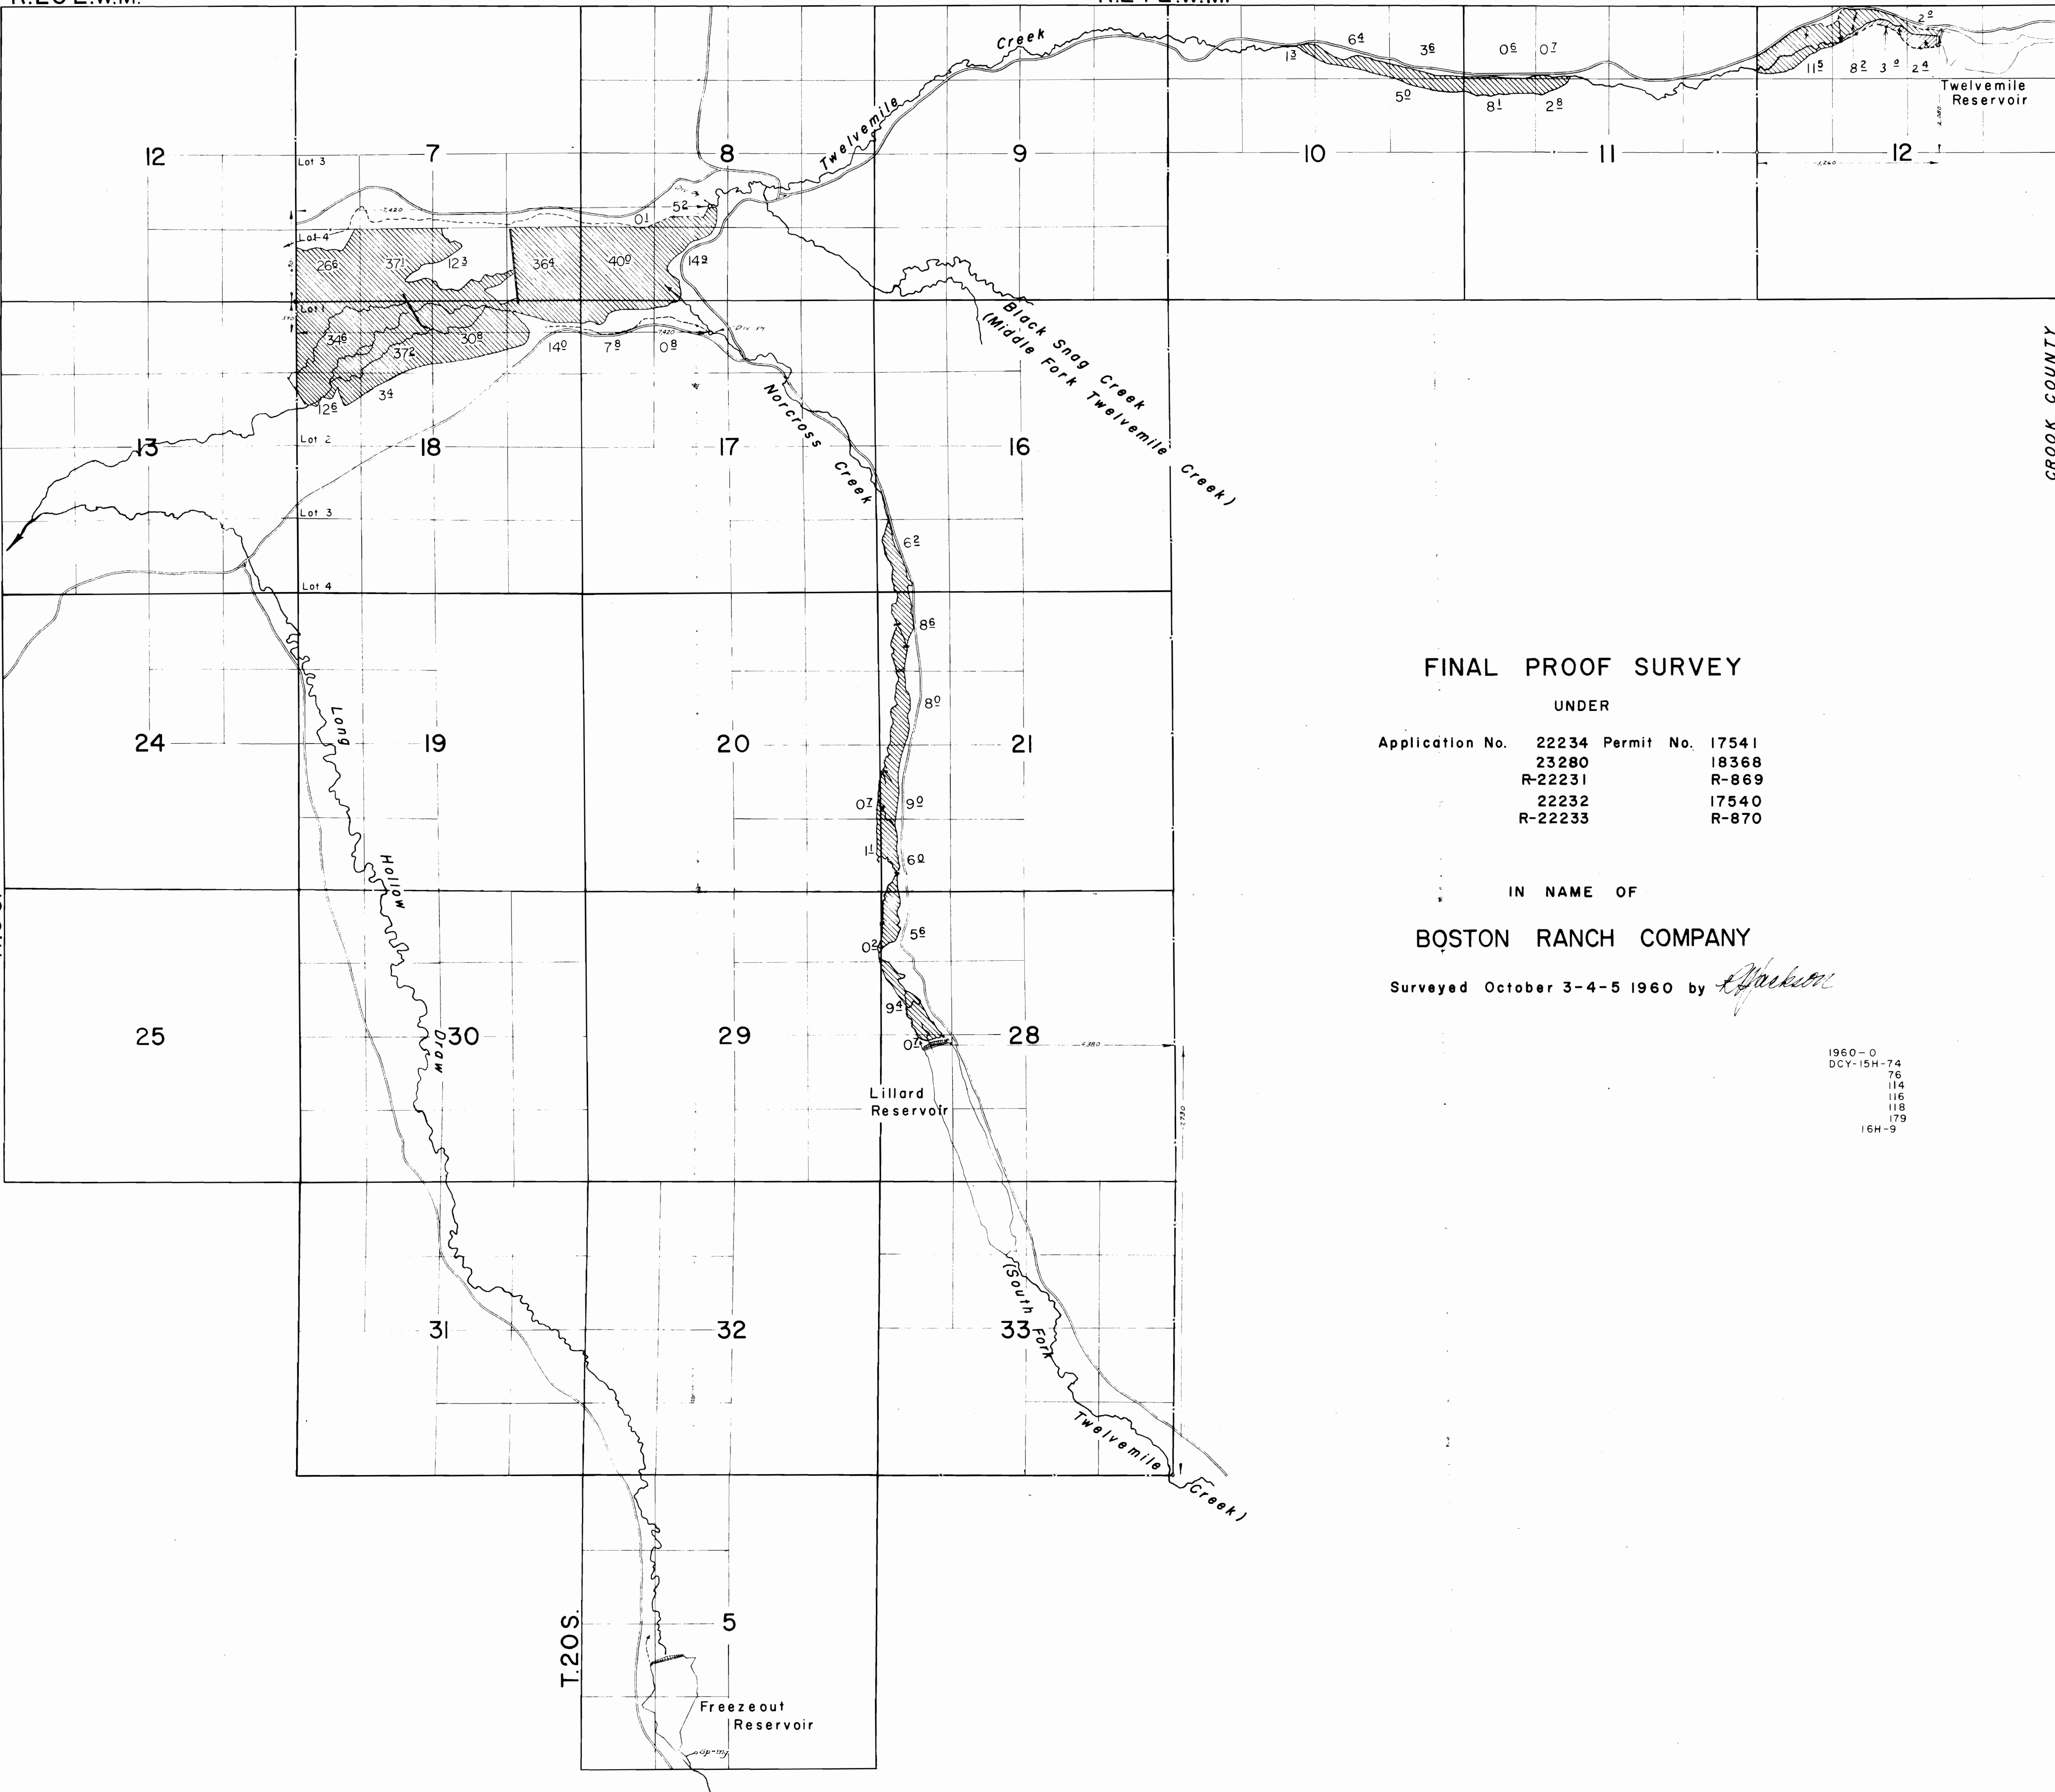

FINAL PROOF SURVEY

UNDER

Application No.	22234	Permit No.	17541
	23280		18368
	R-22231		R-869
	22232		17540
	R-22233		R-870

IN NAME OF

BOSTON RANCH COMPANY

Surveyed October 3-4-5 1960 by *A. Jackson*

1960-0
DCY-15H-74
76
114
116
118
179
16H-9