T. 6 & 7 S. R. 38 E. W. M.

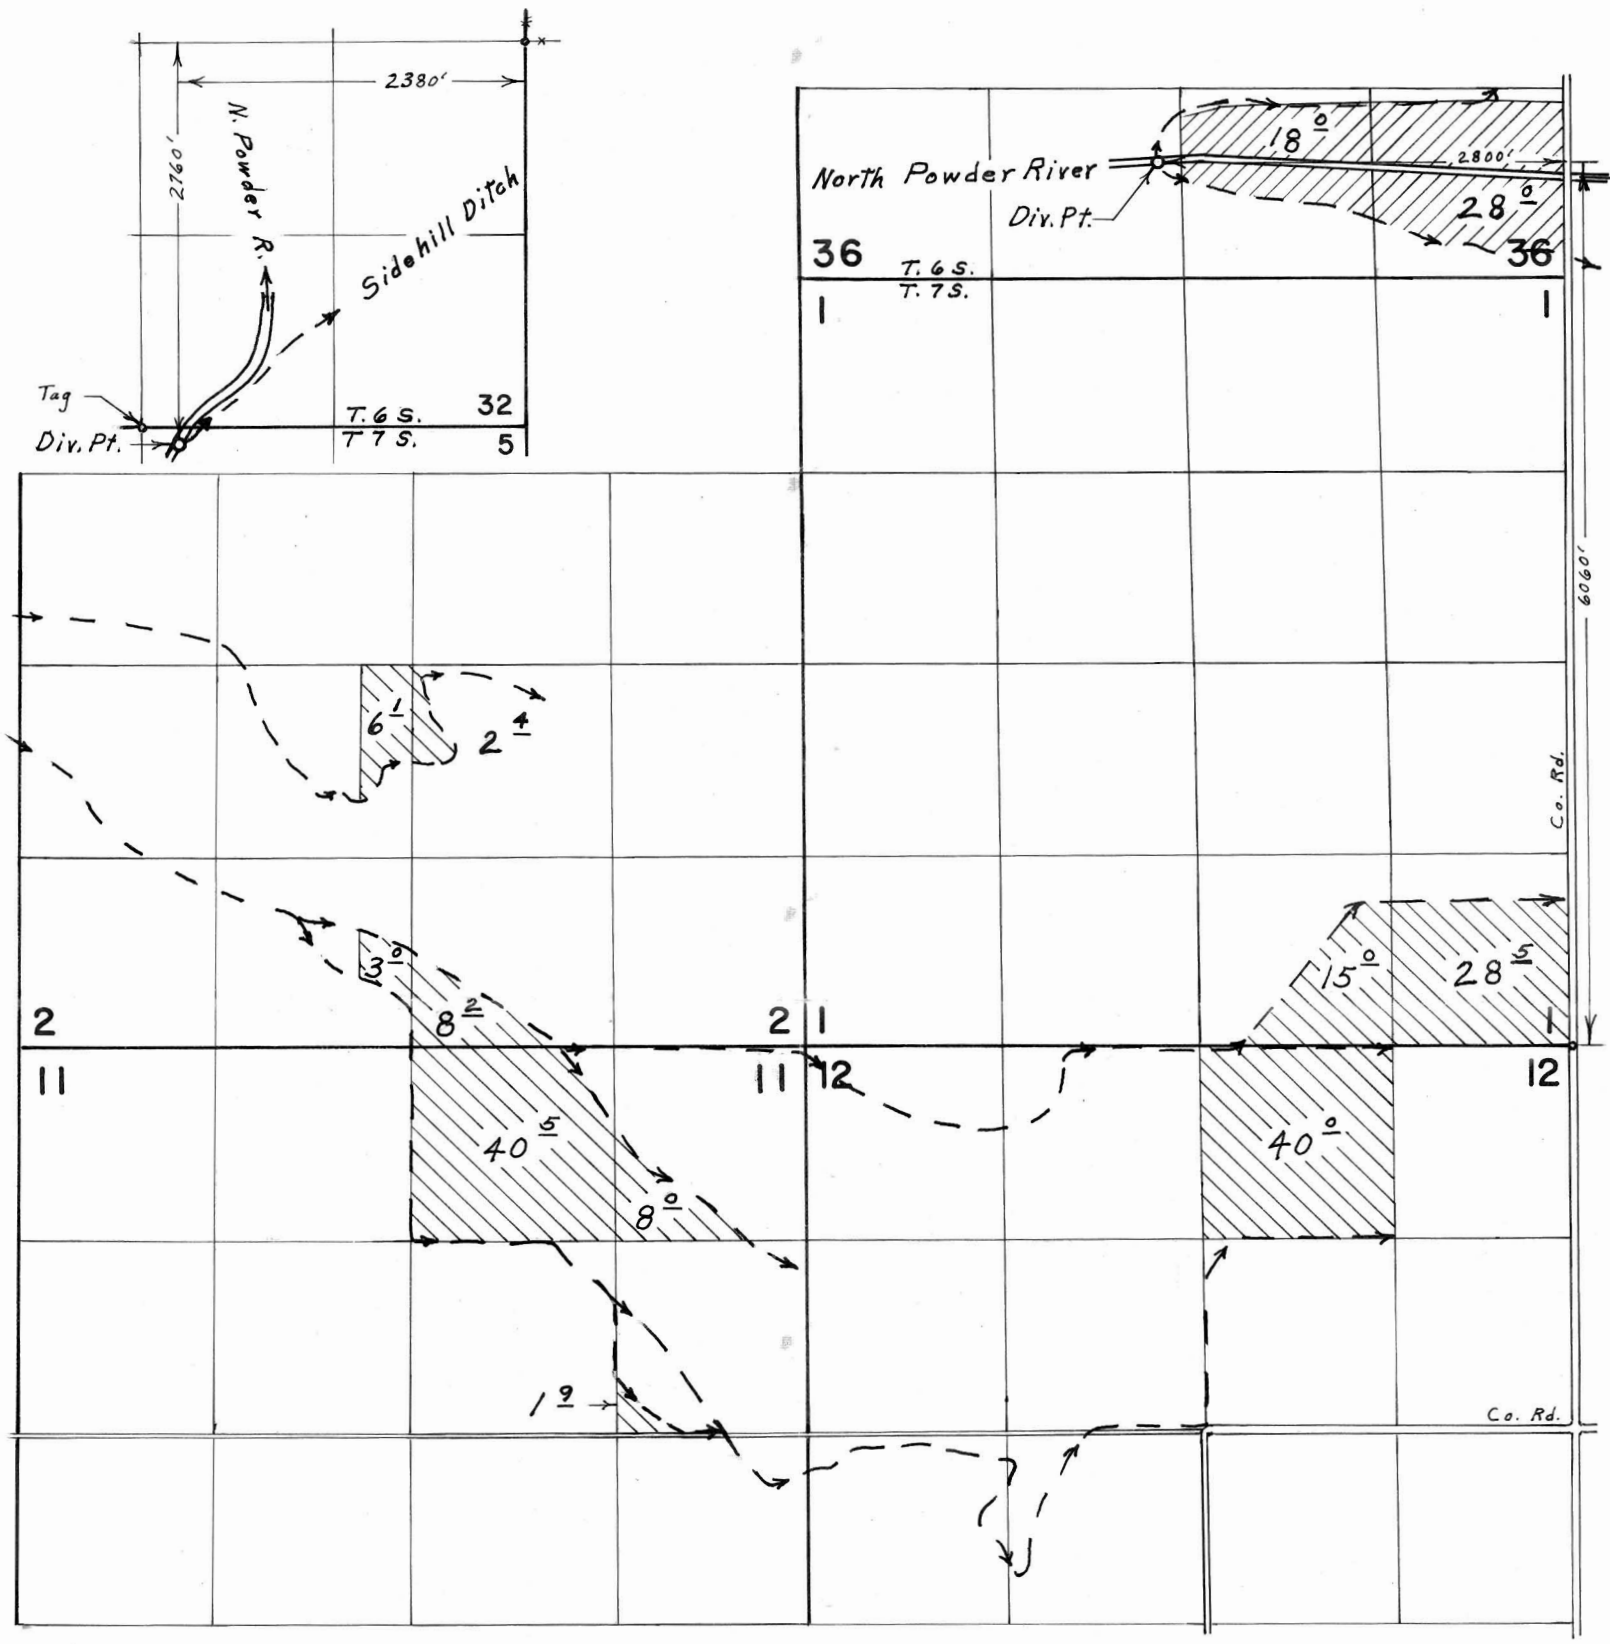

FINAL PROOF SURVEY

UNDER

Application No. 40924 Permit No. 30499

IN NAME OF

MERTON A. & EHRMAN E. DAVIS

Surveyed June 20, 1970, by L. E. Gould