


T.3S.R.1E.W.M.

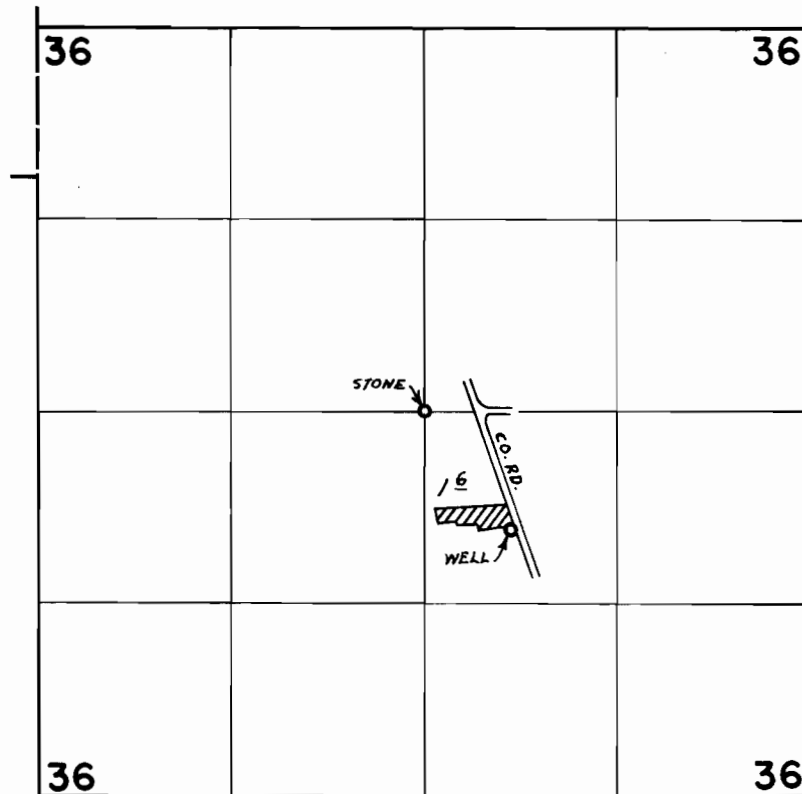

WELL LOC. 820'S. & 590'E. FROM CENTER SEC. 36

FINAL PROOF SURVEY
UNDER

Application No. G-3589 Permit No. G-3377
IN NAME OF

THEODORE RICHTER

Surveyed NOV. 18 1970, by L. E. GOULD