


T.6S.R.2E.W.M.

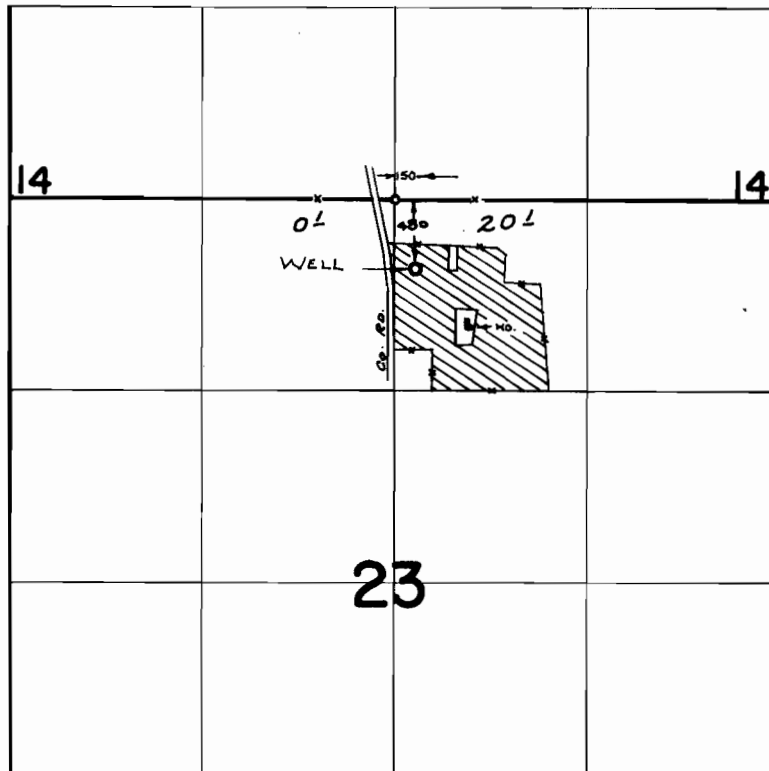

FINAL PROOF SURVEY

UNDER

Application No. G-3992 Permit No. G-3746
IN NAME OF

DUANE WARYE

Surveyed MAY 21, 1971, by R. MUCKEN