


T. 3 S. R. 5 E. W. M.

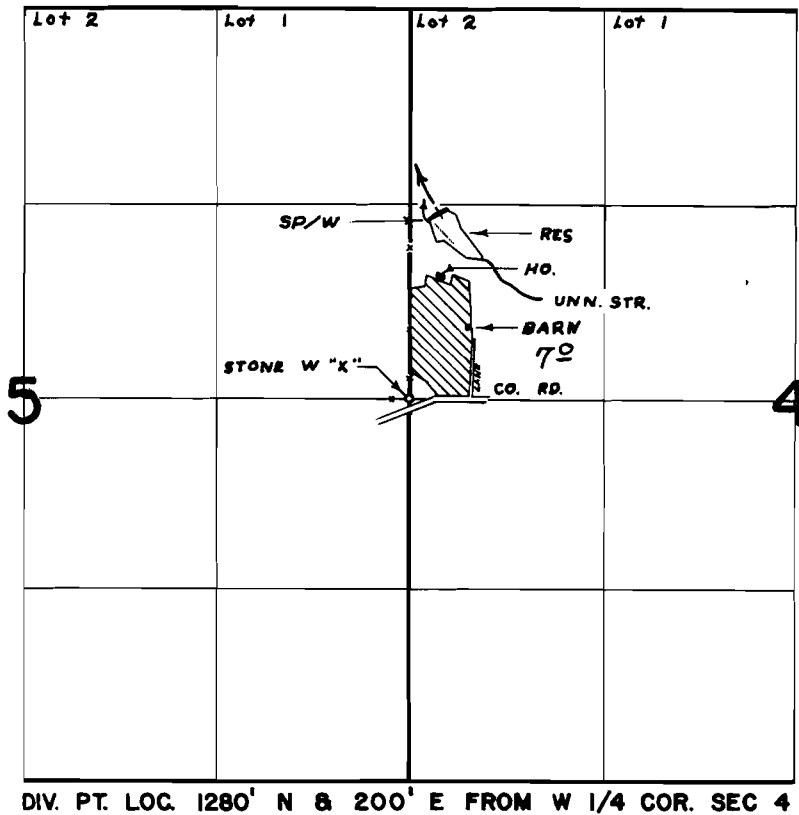

FINAL PROOF SURVEY
UNDER

R - 45311 R - 5247
45312 33219
Application No. 40777 Permit No. 30451...
IN NAME OF

ORVAL M. & MARGARET E. FLESHMAN

Surveyed OCT. 29, 1971, by R. MUCKEN.....