


T. 3 S. R. 2 E. W. M.

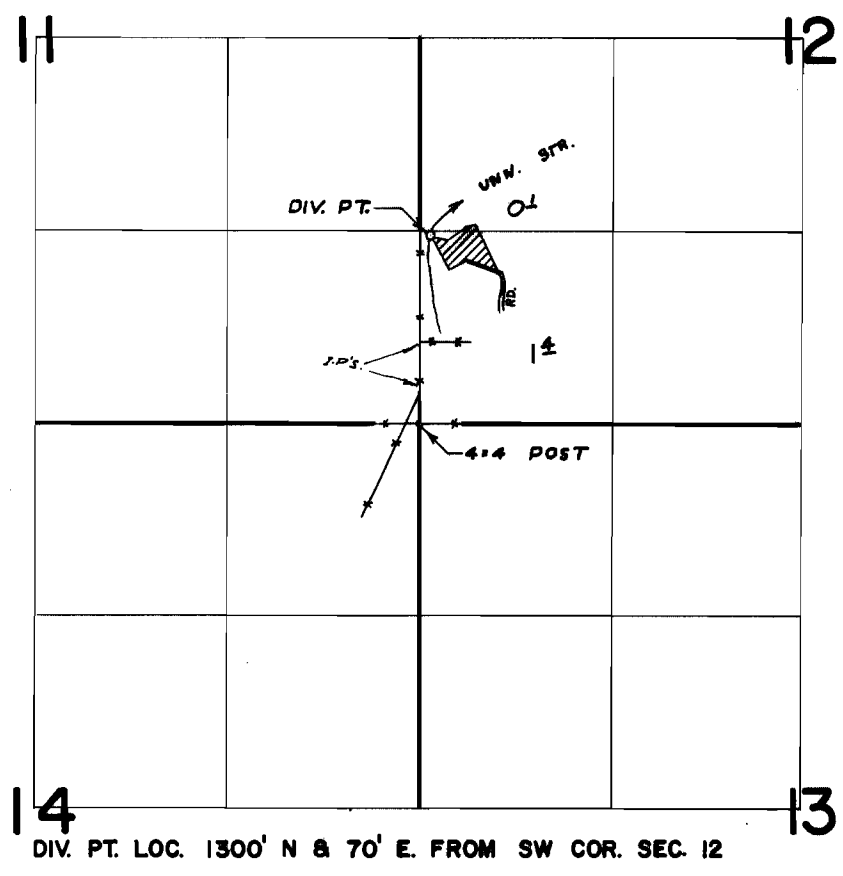

DIV. PT. LOC. 1300' N & 70' E. FROM SW COR. SEC. 12

FINAL PROOF SURVEY UNDER

Application No. 39525..... Permit No. 29610.....
IN NAME OF

.....DOROTHY FLEMING.....

Surveyed AUG. 18, 1970, by D. BUELL.....
APR. 27, 1971, by R. MUCKEN