


T.4S.R.2E.W.M.

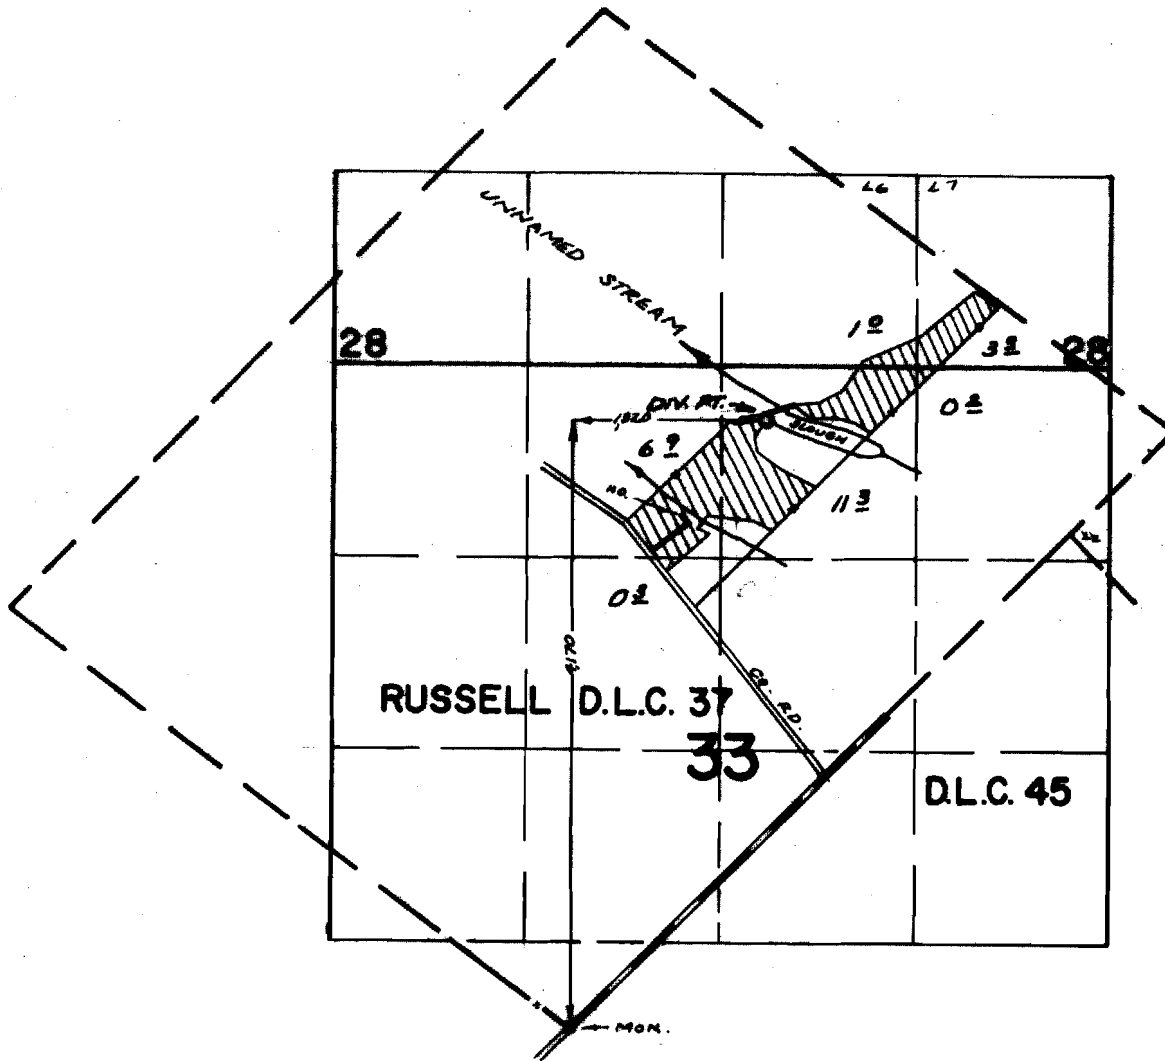

FINAL PROOF SURVEY
UNDER

Application No. 42059 Permit No. 31482
IN NAME OF

GILBERT KANGISER

Surveyed OCT. 22, 1971, by R. MUCKEN