T. 2 S. R. 2 E. W. M.

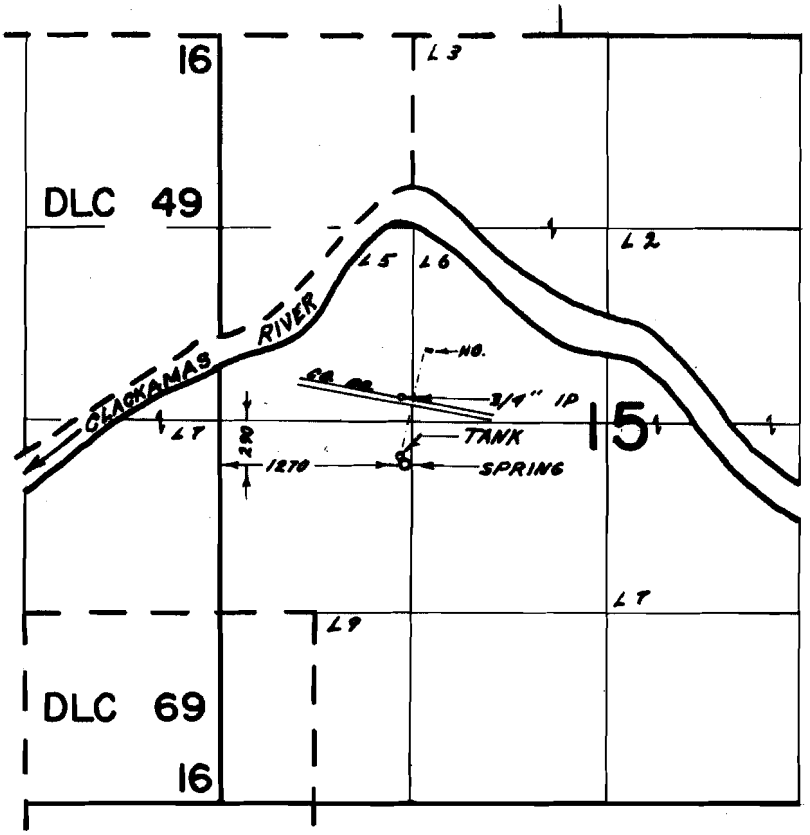

FINAL PROOF SURVEY
UNDER

Application No. 46352 Permit No. 34597
IN NAME OF

R. SCOTT FURST

Surveyed OCT. 28, 1971, by R. MUCKEN

1971 0 TOP