


# T. 8 N. R 7 W. W.M.

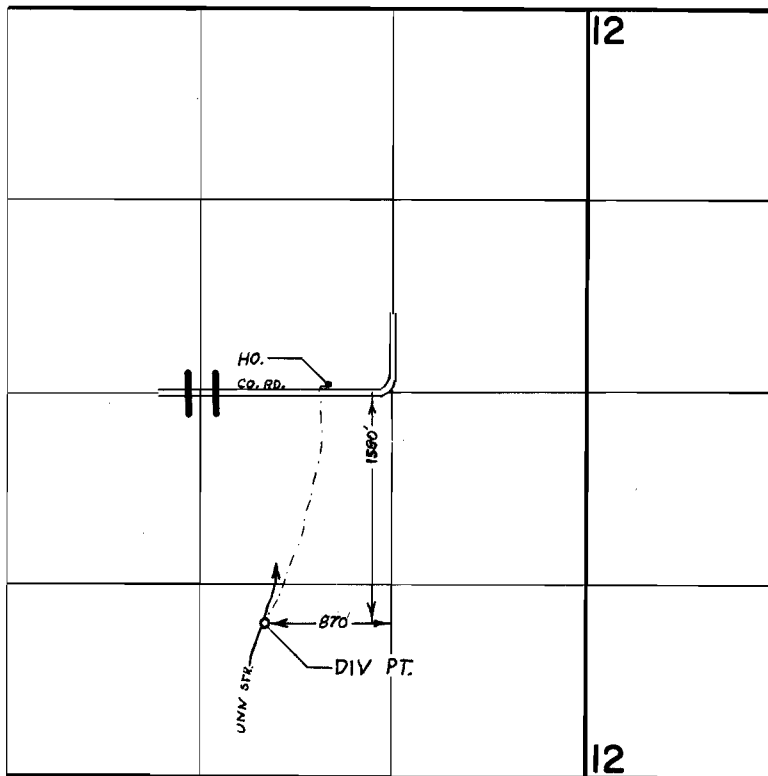

## FINAL PROOF SURVEY UNDER

Application No. 39914 Permit No. 29709  
IN NAME OF

EDWIN H. BACKANEN

Surveyed JUNE 9 & 10, 1971, by R. MUCKEN