


T.6N.R.6W.W.M.

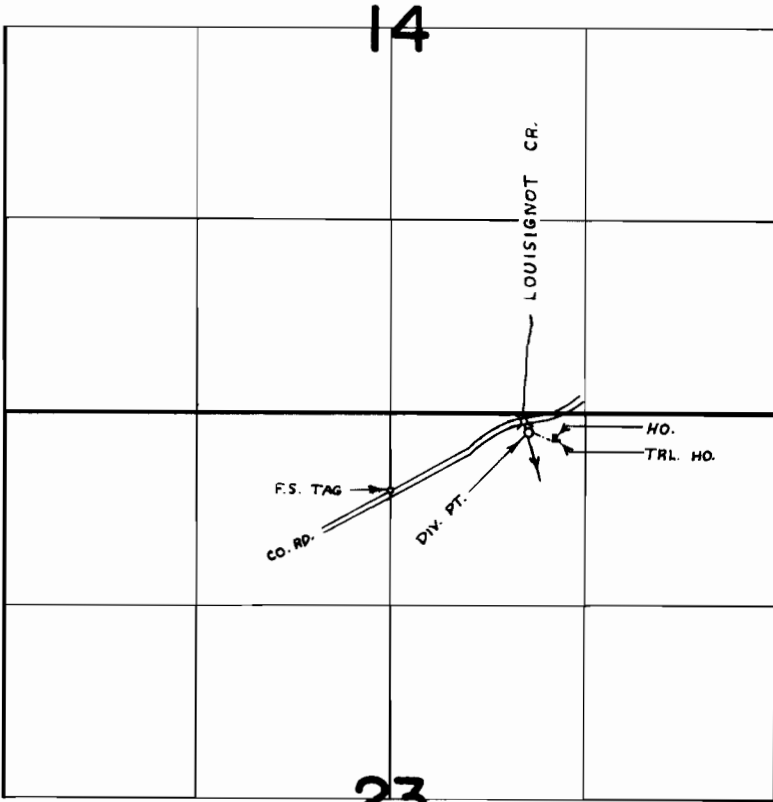

23

DIV. PT. LOC. 130' S. & 950' E. FROM N. 1/4 COR. SEC. 23

FINAL PROOF SURVEY

UNDER

Application No. 46054 Permit No. 34391
IN NAME OF

RALPH ROTH

Surveyed JUNE 8, 1971, by R. MUCKEN