


T.24S.R.3W.W.M.

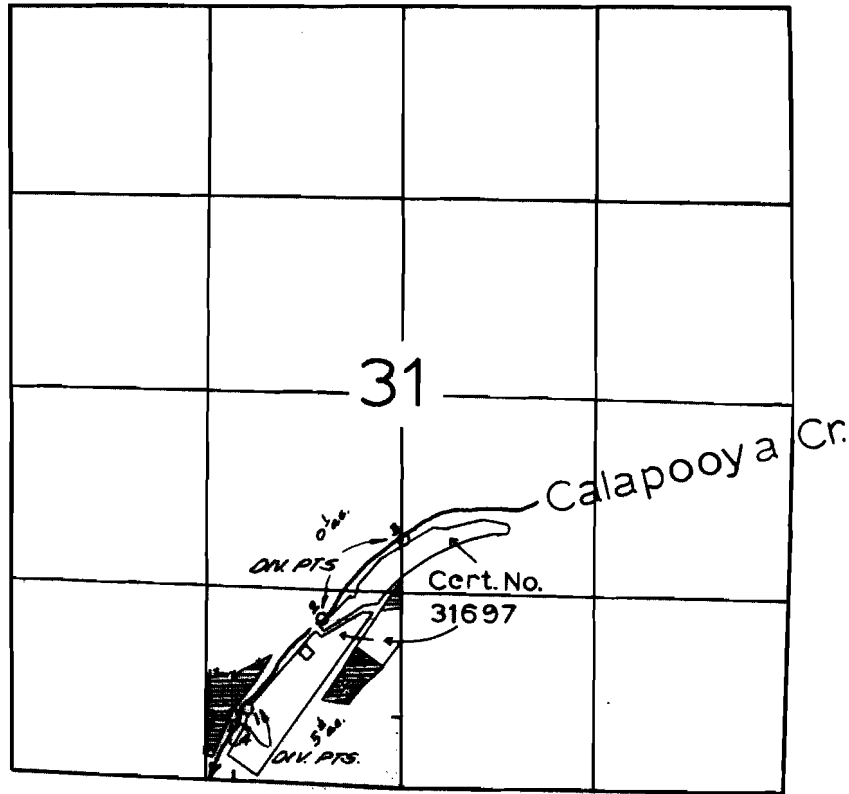

*DIV. PTS. LOCATED:- 1, 540' N. & 1060' W.; 2, 1160' N. & 540' W.;
3, 1700' N. & 10' E.; 4, 480' N. & 1140' W.; ALL FROM THE S. & COR.
OF SECTION 31.*

**FINAL PROOF SURVEY
UNDER**

Application No. 42125..... Permit No. 31597.....
IN NAME OF

T.M. Roper

Surveyed 2-18..... 1972, by M.J. Youngquist.....
3-13 72 F. P. Cogswell