


T. 38 S. R. 2 W. W. M.

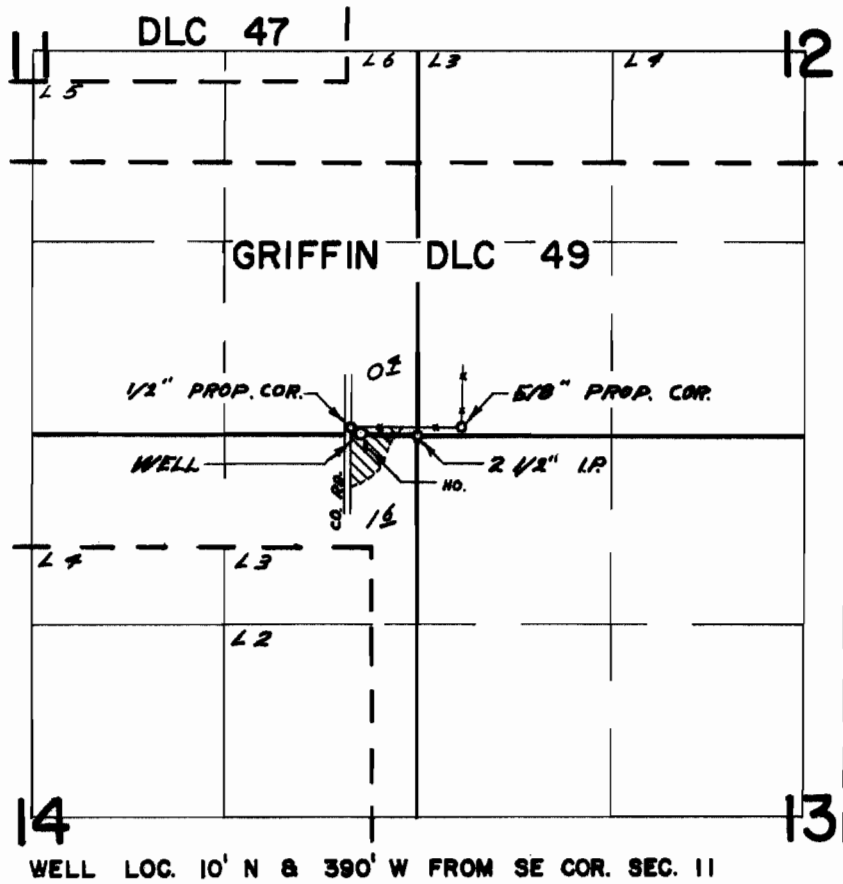

**FINAL PROOF SURVEY**  
UNDER

Application No. G...5006 Permit No. G...4724  
IN NAME OF

**LEE S. & GEORGIA V. COGGINS**

Surveyed OCT. 12, 1971, by R. MUCKEN