


T. 38 S. R. 2 W. W.M.

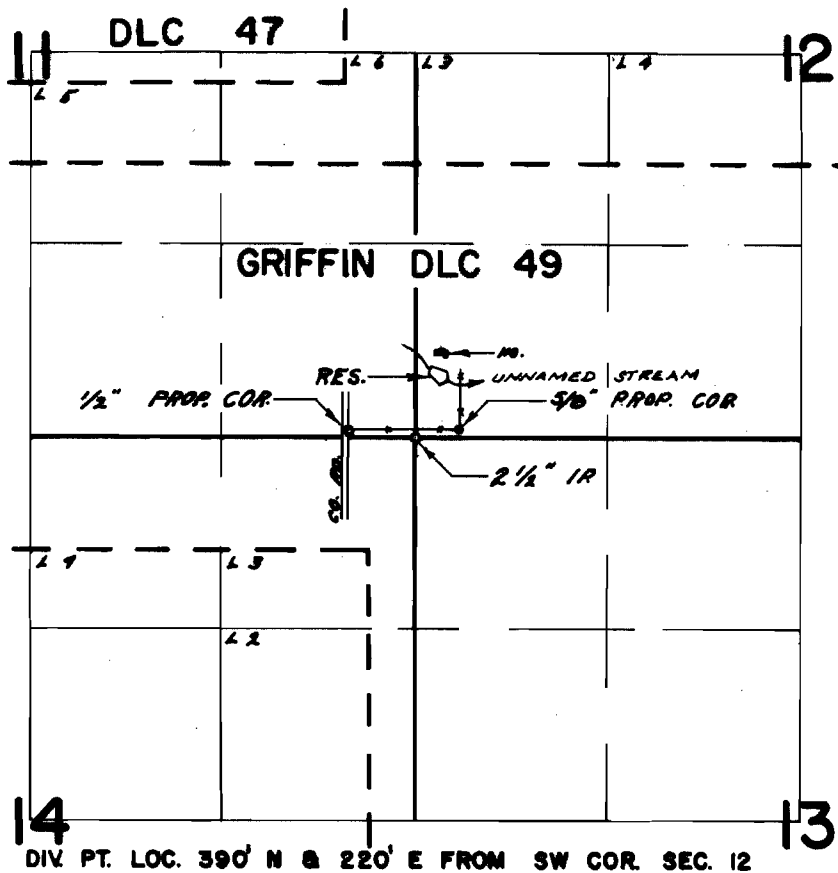

FINAL PROOF SURVEY UNDER

Application No. R-45408 Permit No. R-5366..
IN NAME OF

.....J. RALPH BERWANGER.....

Surveyed OCT. 10., 1971., by R. MUCKEN.....