


T.4 O S.R.3 W.W.M.

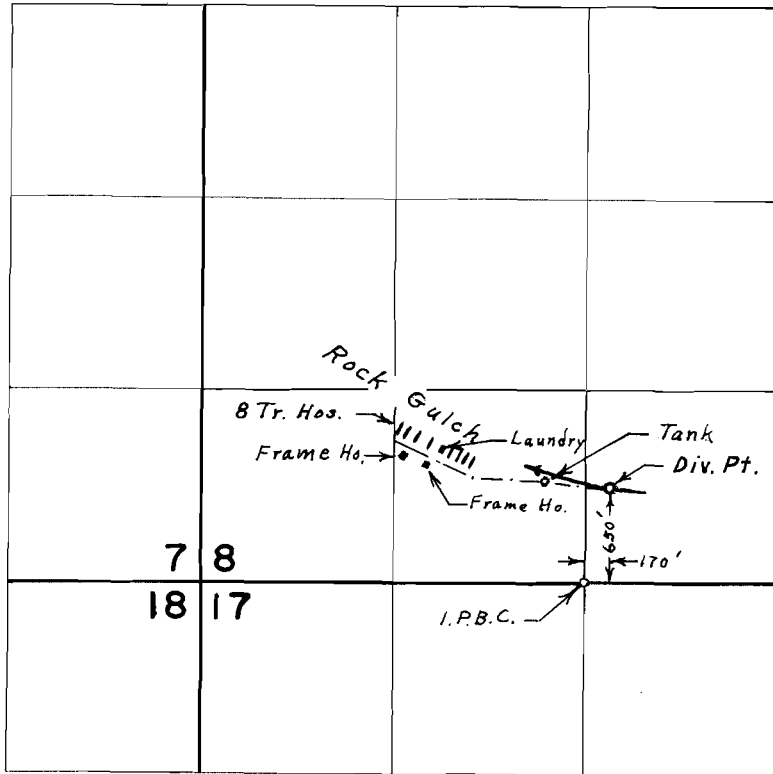

FINAL PROOF SURVEY
UNDER

Application No. 39988 Permit No. 29787
IN NAME OF

DONALD E. FOSSEN

Surveyed Sept. 20, 1971, by L. E. Gould