


T.39 & 40 S. R.3 W. W.M.

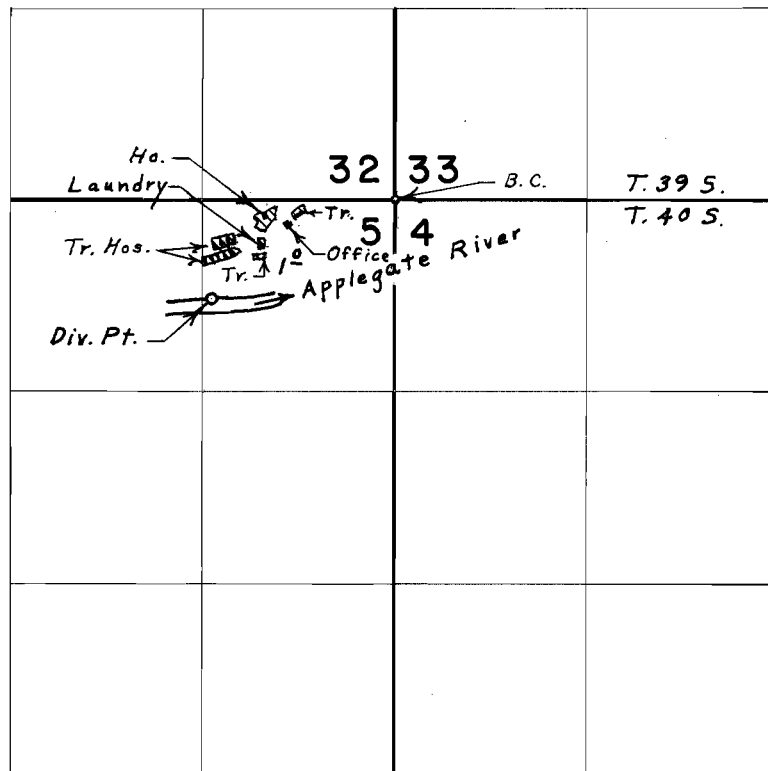

Div. Pt. located 680' S. & 750' W. from N.E. Cor. Sec. 5

FINAL PROOF SURVEY
UNDER

Application No. 42297 Permit No. 31631
IN NAME OF

LAURA BERTZ

Surveyed Sept. 20, 1971, by L. E. Gould