


T. 3 4 S. R. 1 W. W. M.

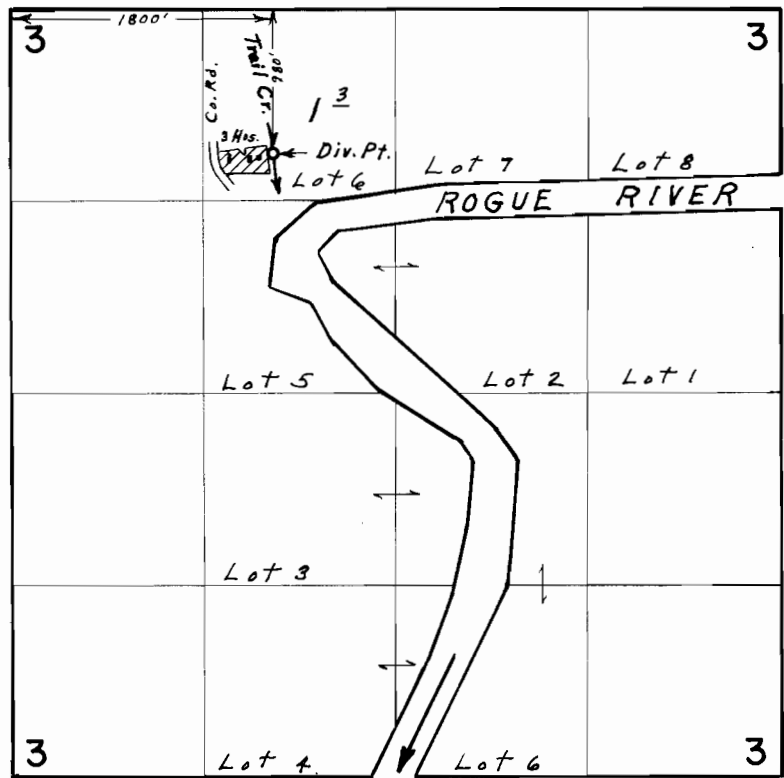

FINAL PROOF SURVEY UNDER

Application No. 43173 Permit No. 31862
IN NAME OF

M. B. MEGLASSON

Surveyed May 4, 1971, by L. E. Gould