


38447
38447

T 38 & 39 S. R. 3 E. W. M.

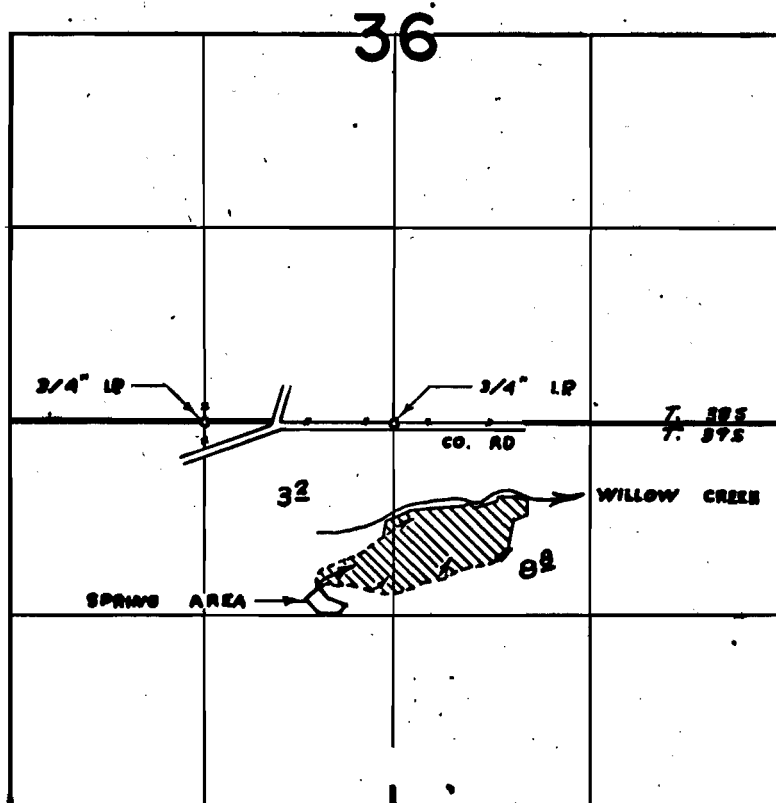

SPRING AREA LOC. 1240' S & 430' W FROM N 1/4 COR. SEC 1

FINAL PROOF SURVEY
UNDER

Application No. 44187... Permit No. 33016...
IN NAME OF

LOUISE ODEN

Surveyed OCT. 13, 1971, by R. MUCKEN

my 2 GP