T. 38S. R. 6&7 W.W.M.

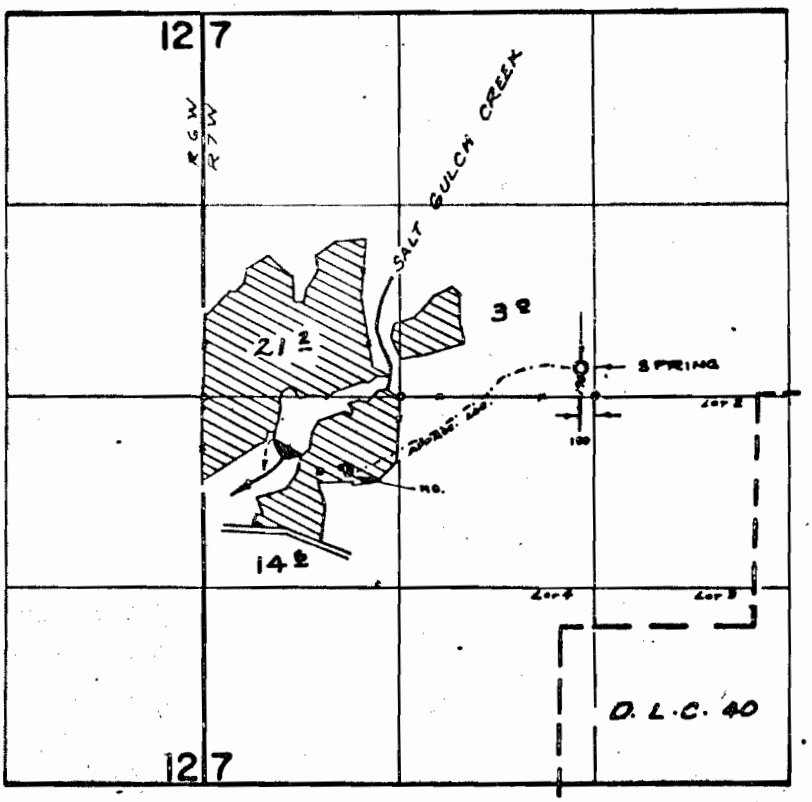

DIV. PT. LOC: 360'S. & 570'E. FROM E¼ COR. SEC. 7

FINAL PROOF SURVEY
UNDER

R-41470 41382 R-4608 30263

Application No. 45235 Permit No. 33793

IN NAME OF

CHARLES S. MOORE

Surveyed APR. 17 19 70, by D. R. BUELL

A.E.M. 1770-A