


**RECEIVED**

JUN 15 1972

STATE ENGINEER  
SALEM, OREGON

**T.33S.R.5W.W.M.**

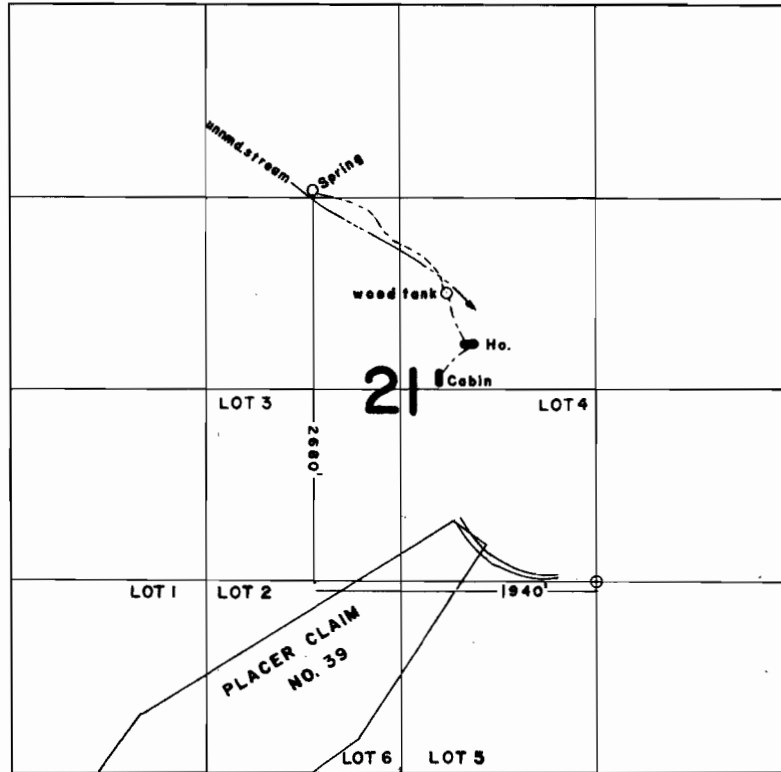

**FINAL PROOF SURVEY  
UNDER**

Application No. 48358... Permit No. 35337...  
IN NAME OF

**MR. & MRS. W. J. DILLON**

Surveyed JUNE 7... 1972, by R.B. STEIMER..