


T.33 & 34 S.R.7 1/2 E.W.M.

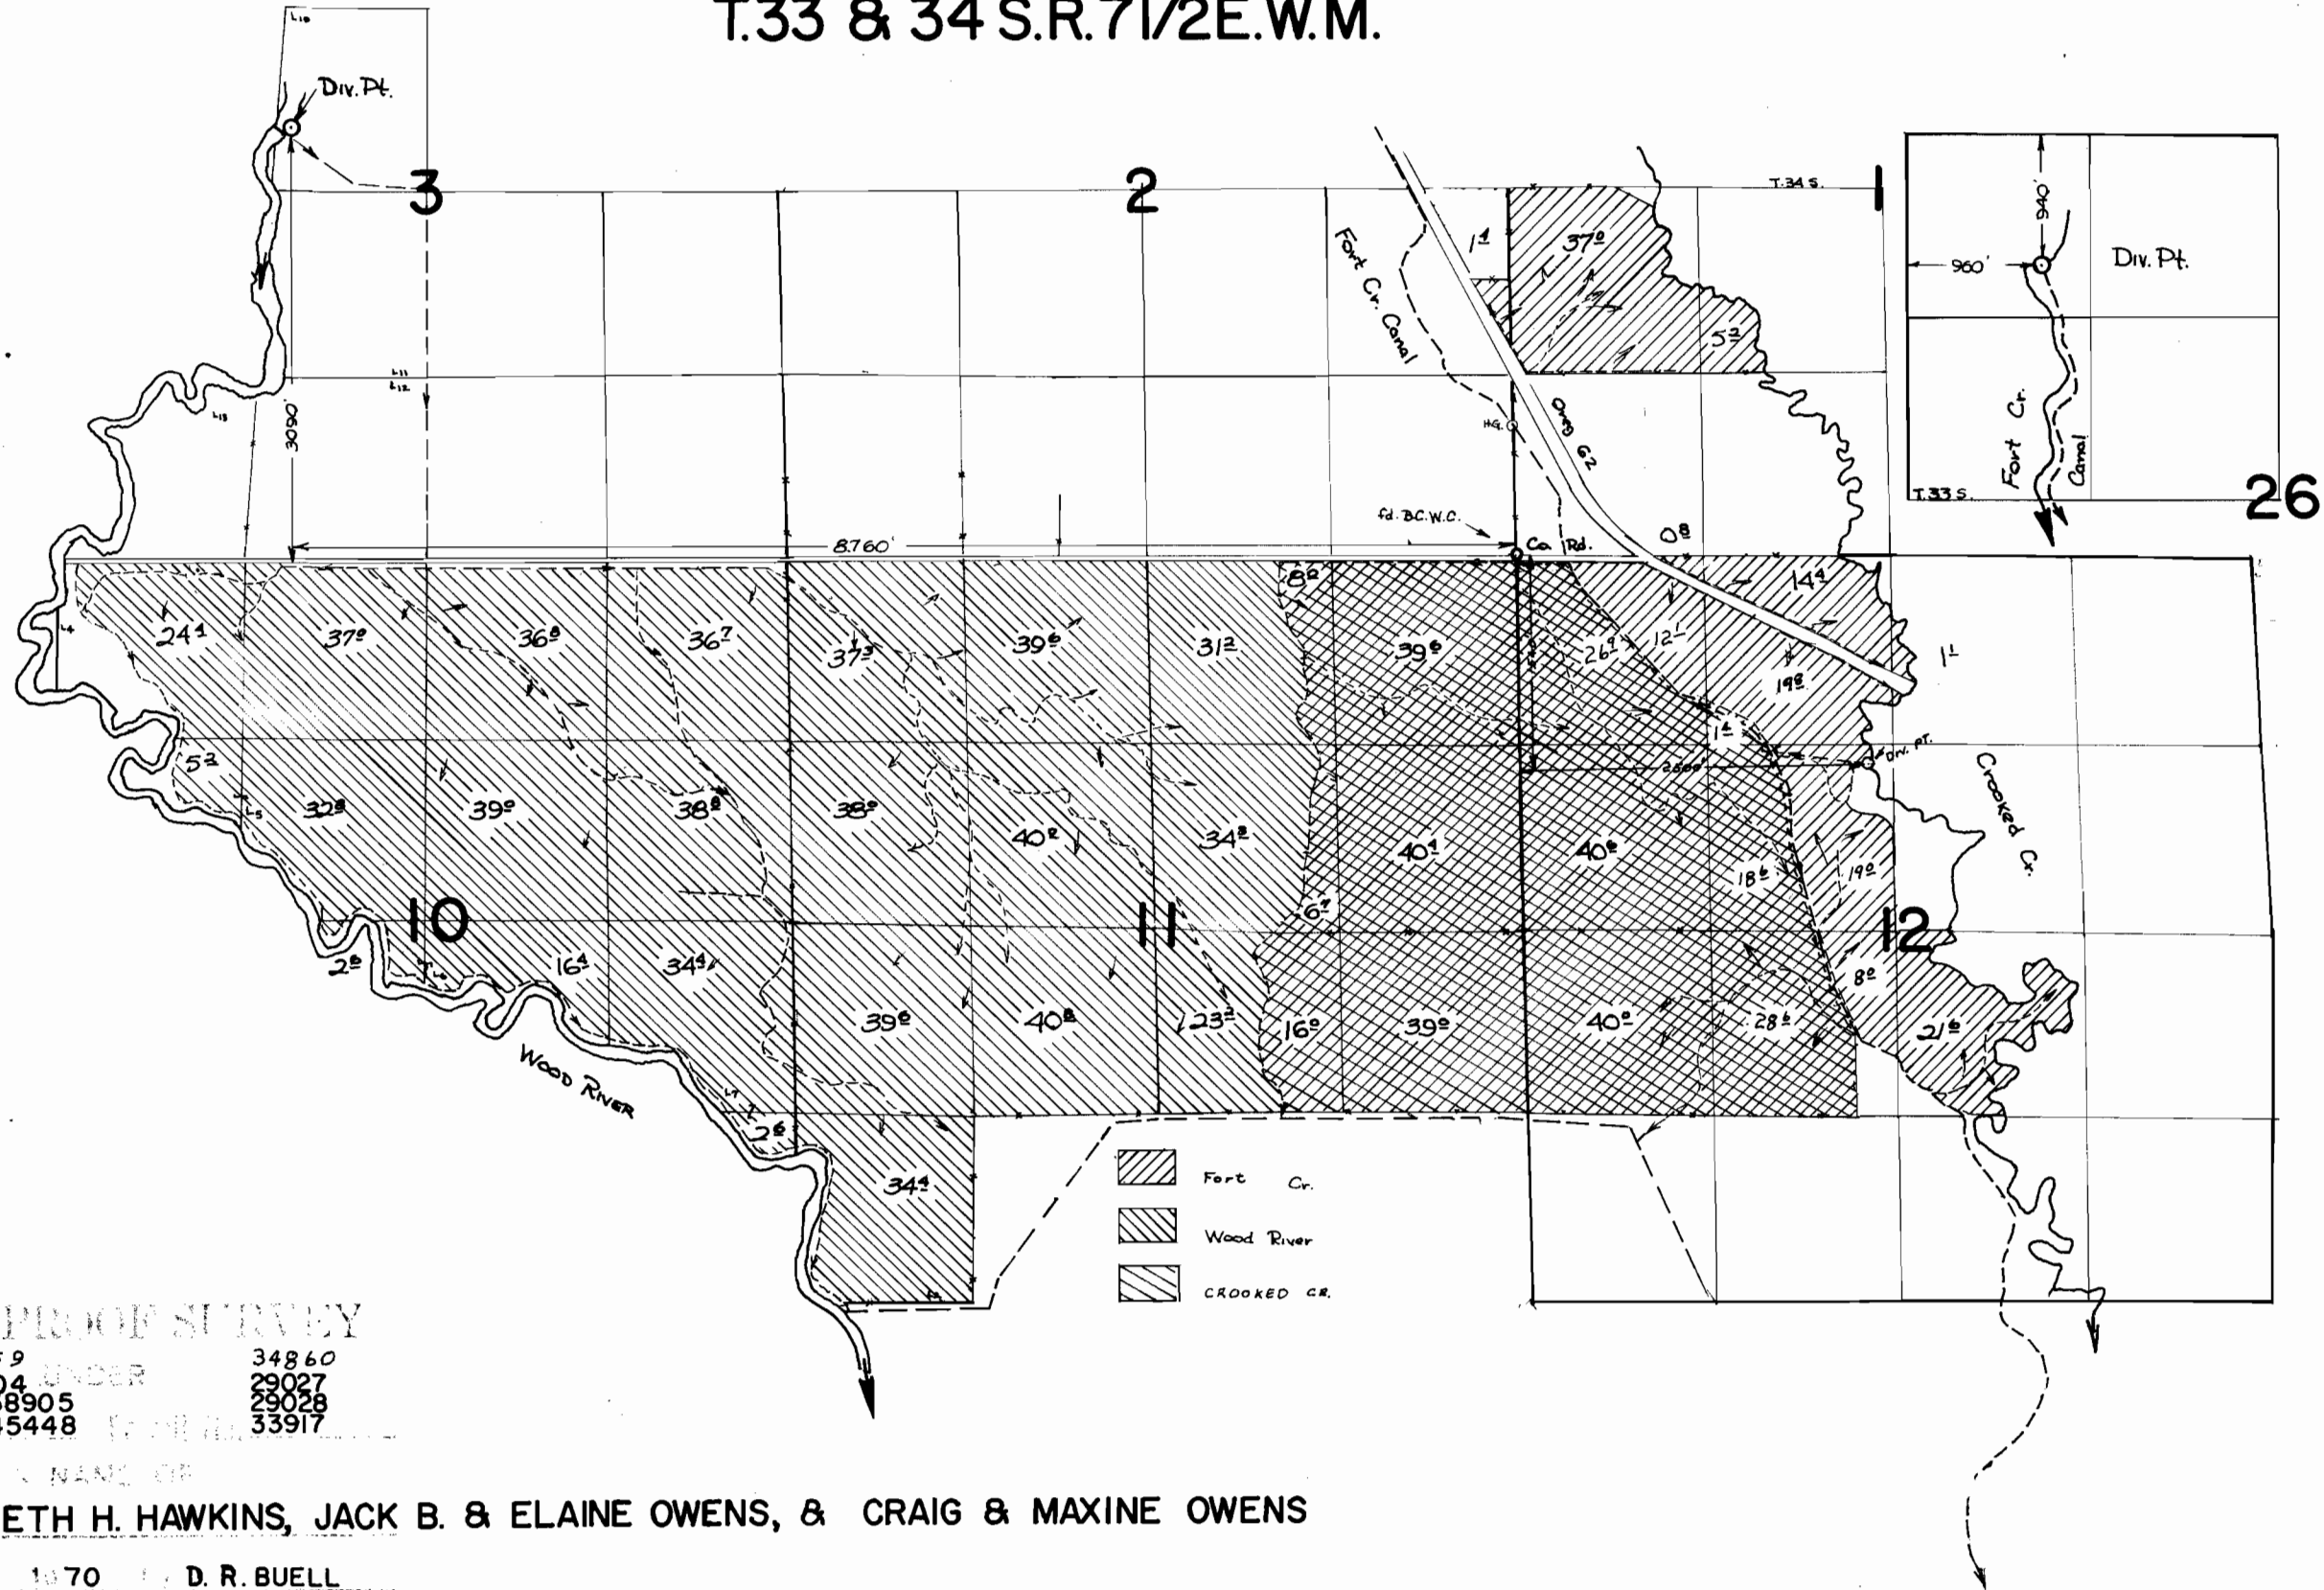

FINAL PROOF SURVEY

46659 34860
 38904 UNDER 29027
 38905 29028
 45448 33917

IN NAME OF

THOMAS W. & ELIZABETH H. HAWKINS, JACK B. & ELAINE OWENS, & CRAIG & MAXINE OWENS

Surveyed 21 MAY 1970 by D. R. BUELL

OCT. 19, 1974 L.H. NUNN