


T. 40S. R. 8E. W.M.

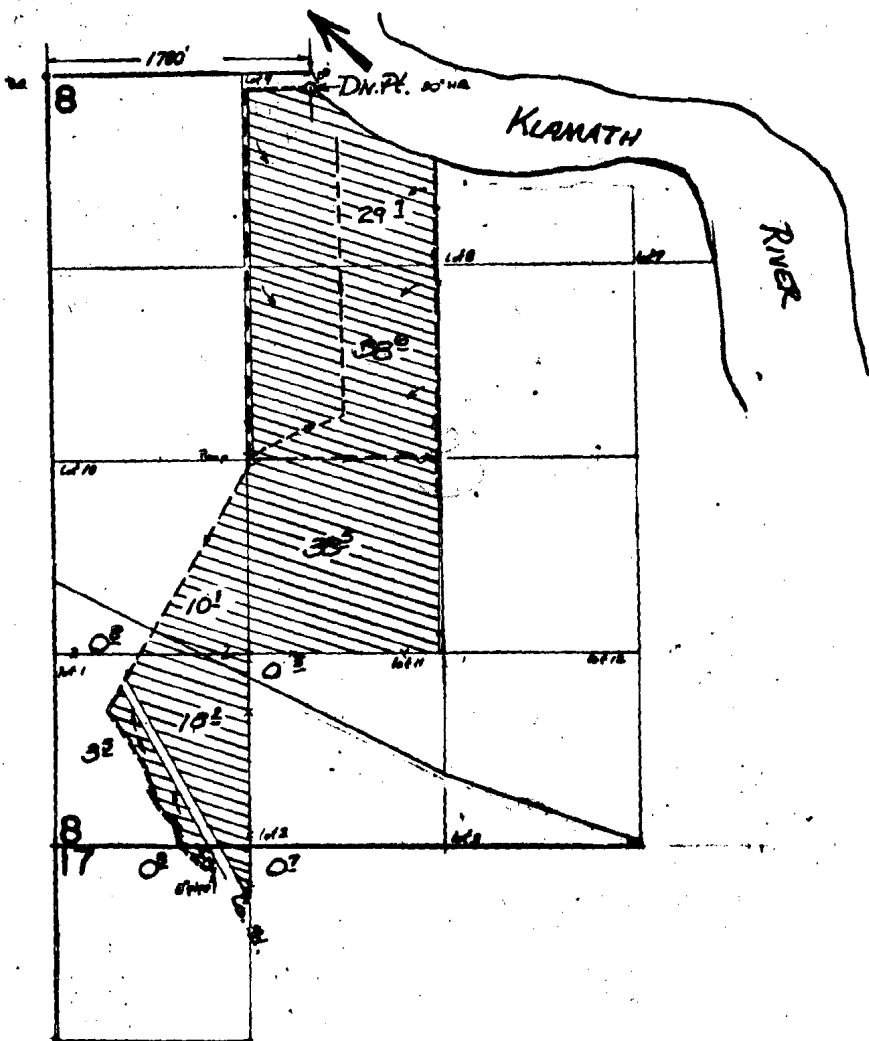

FINAL PROOF SURVEY UNDER

Application No. 41981..... Permit No. 31423.....
IN NAME OF

LLOYD HOWARD

Surveyed 26 NOV..... 1970., by G. BACA.....