


R 2582-3

38458

T. 37 S. R. 24 E. W.M.

Sec P 27163

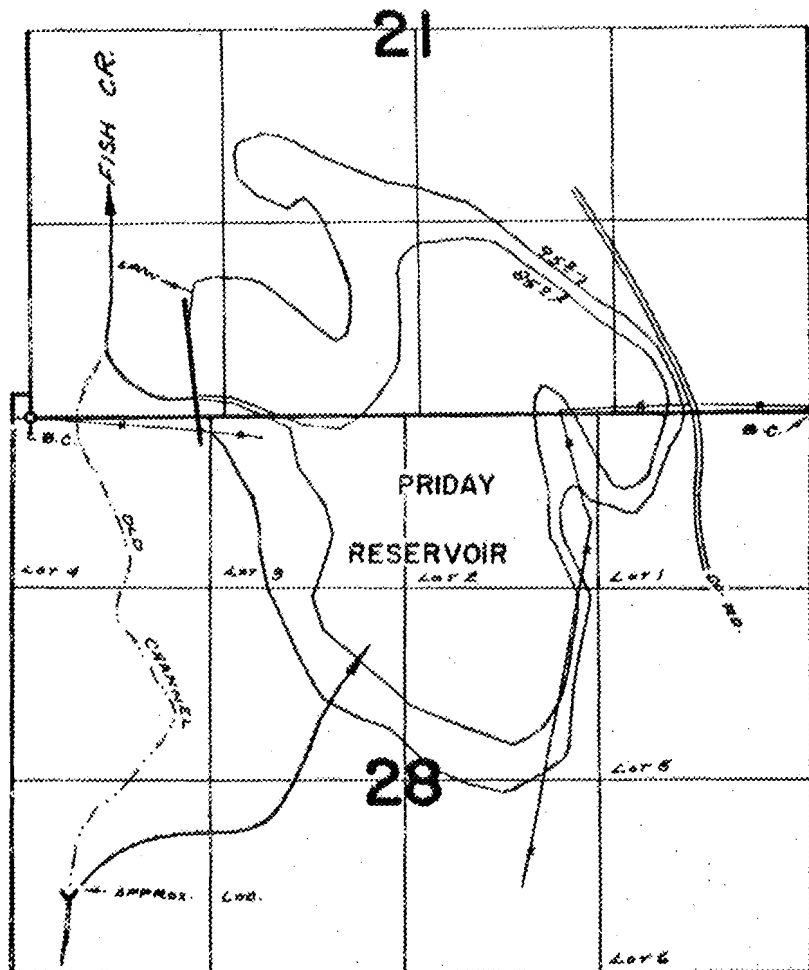

FINAL PROOF SURVEY

UNDER

Application No. R-34473 Permit No. R-2582

IN NAME OF

JERRY BARRY, JR.

Surveyed July 20, 1970, by R. MUCKEN

37-24