
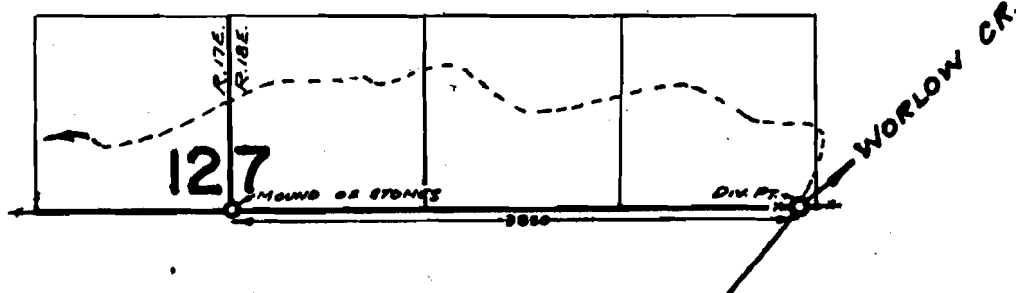


25415
3841

T. 33S. R. 17E. & 18E. W.M.

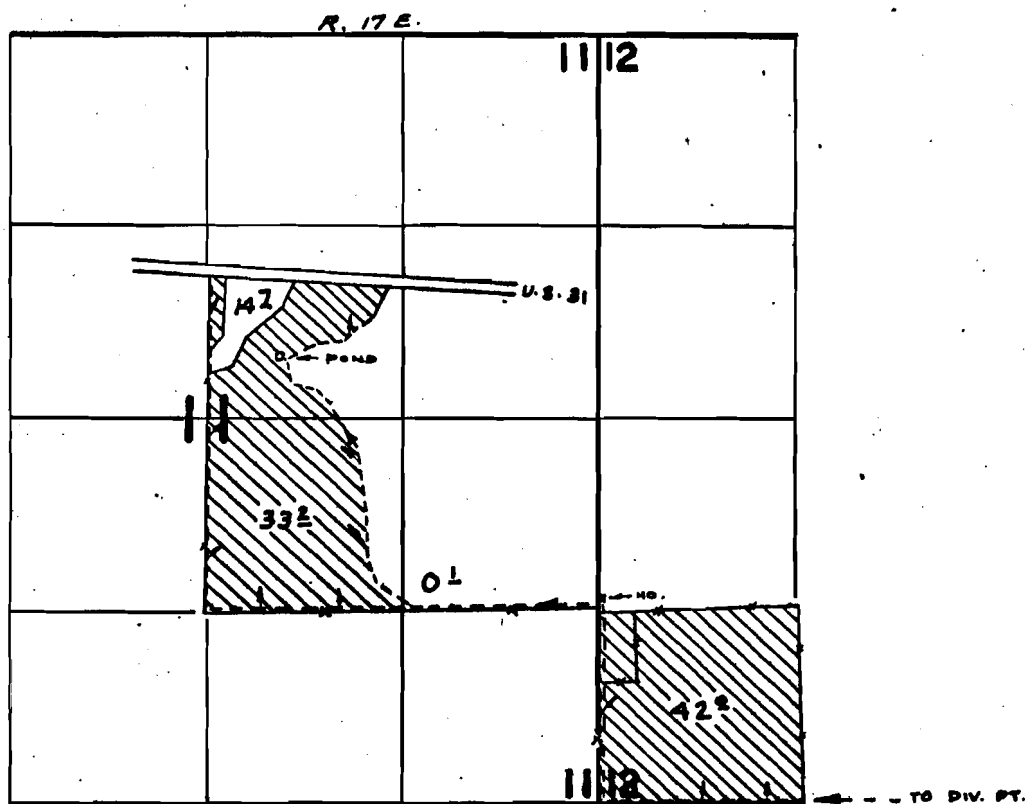

FINAL PROOF SURVEY

UNDER

Application No. 32210 Permit No. 25415

IN NAME OF

JOHN M. & JOHN L. MURPHY

Surveyed JUNE 27 19 70, by R. MUCKEN

33-1 7,18 ✓