


T.40S.R.22E.W.M.

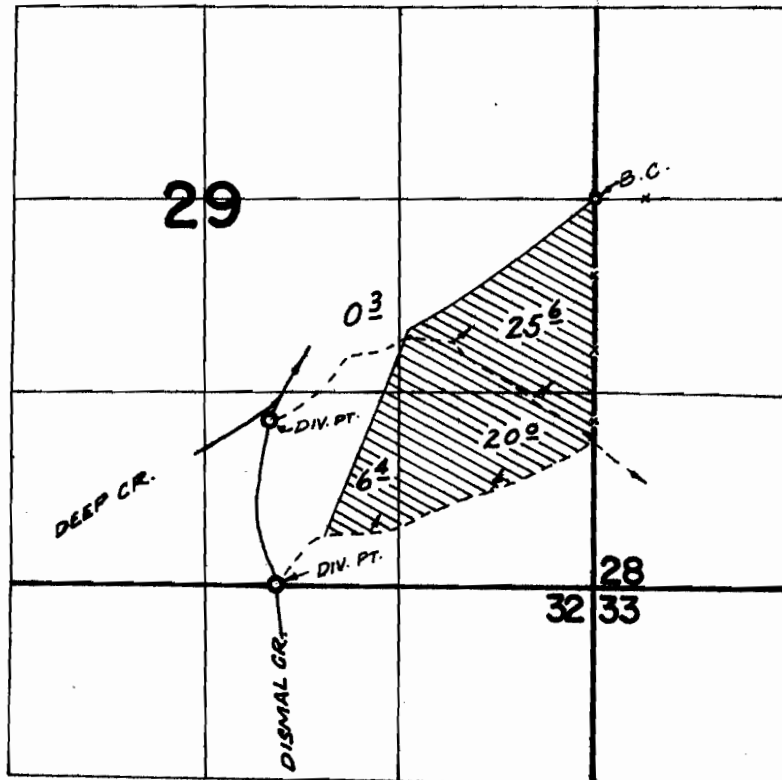

DIV. PTS. LOC: 1510'S. & 2230'W.; 2640'S. & 2170'W., BOTH FROM E. 1/4 COR. SEC. 29

FINAL PROOF SURVEY

UNDER

Application No. 34768 Permit No. 27321

IN NAME OF

B. C. ROBINSON

Surveyed July 17, 1970, by R. MUCKEN