


T.16&17S.R.4W.W.M.

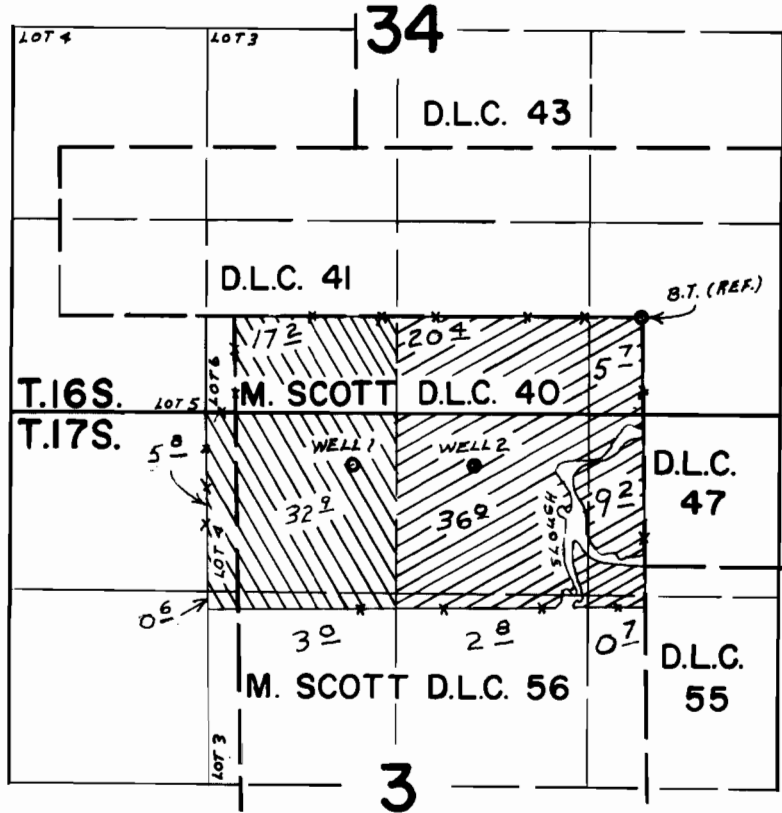

WELLS LOC.: #1 - 1030'S. & 1980'W.; #2 - 1030'S. & 1160'W.;
 BOTH FROM NE COR. M. SCOTT D.L.C. 40

FINAL PROOF SURVEY UNDER

Application No. G-3630 Permit No. G-3413
 IN NAME OF

GORDON W. ELLIOTT

Surveyed OCT. 5 1970 by G. BACA
JULY 6 1971, by G. BACA