


T.17S.R.2W.W.M.

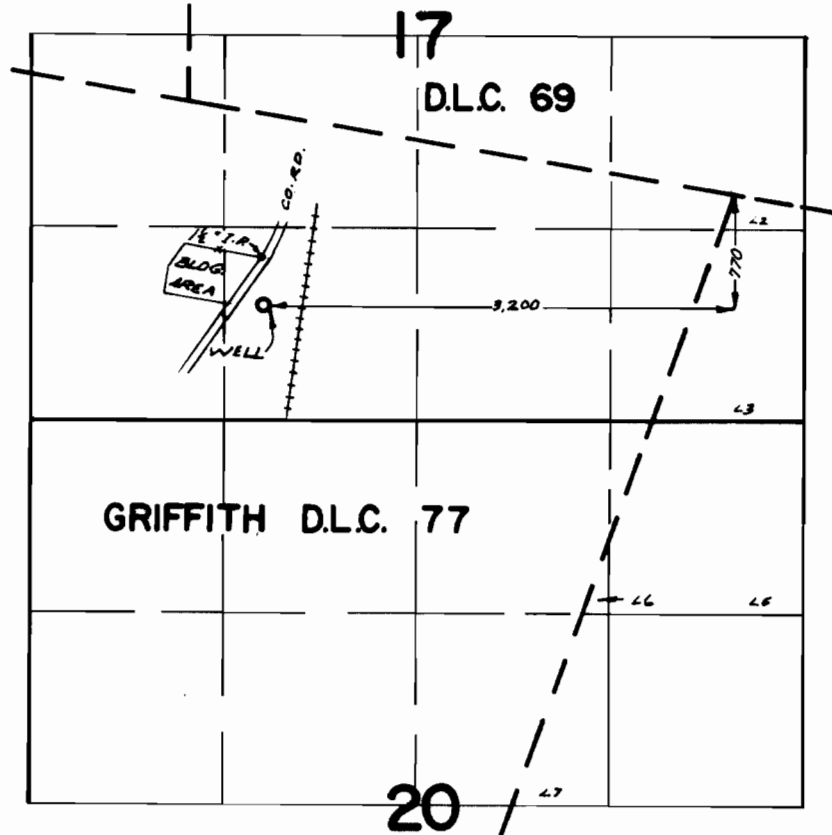

FINAL PROOF SURVEY UNDER

Application No. G-4757 Permit No. G-4550

IN NAME OF
GEORGIA-PACIFIC CORP.
SPRINGFIELD DIV. YARNELL PLANT

Surveyed Nov. 13, 1920, by R. MUCKEN