


T. 15 S. R. 5 W. W.M.

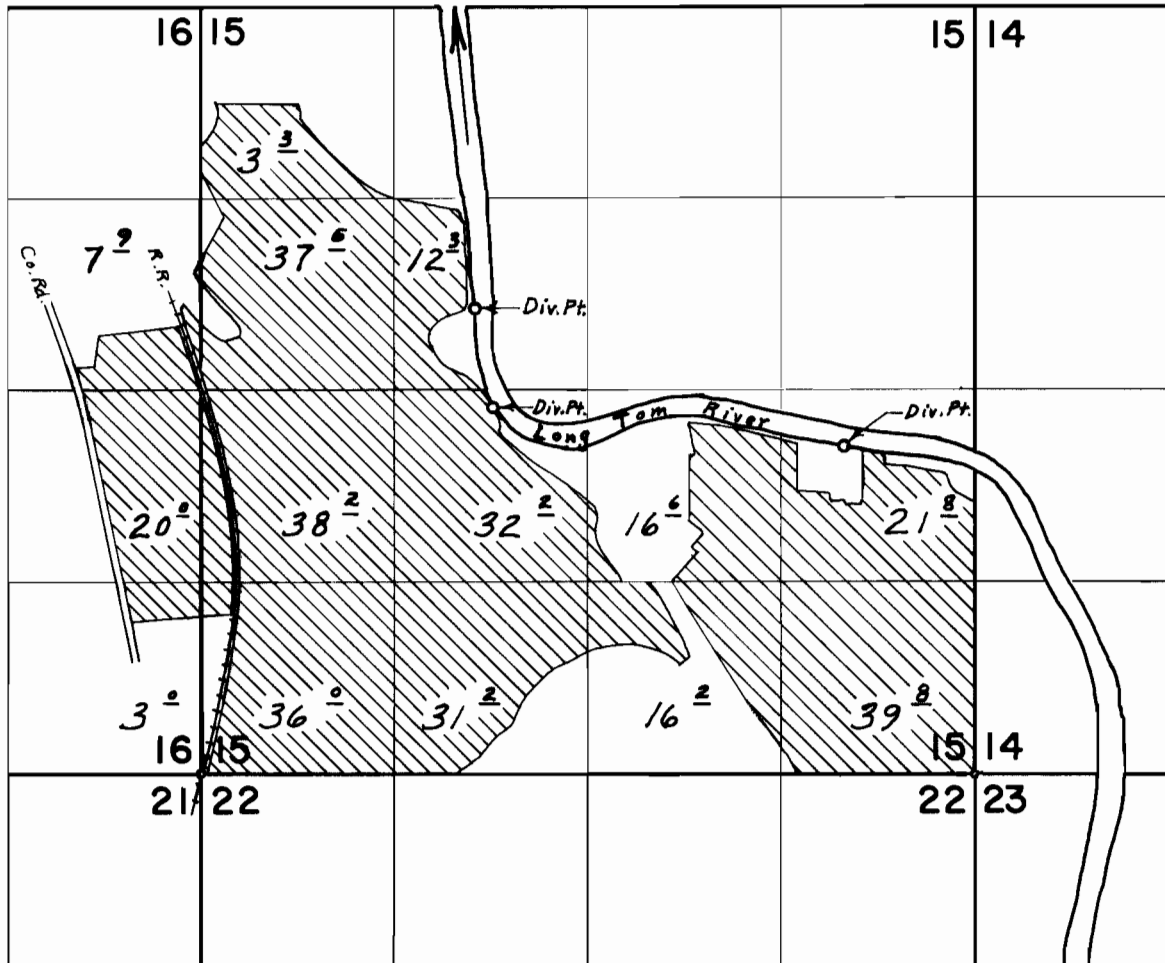

Div. Pts. located: 3200' N. & 3400' W.; 2520' N. & 3285' W.; 2250' N. & 880' W.; all from S.E. Cor. Sec. 15

FINAL PROOF SURVEY UNDER

Application No. 39266 Permit No. 29247
IN NAME OF

ANDREW C. THOMSON Jr.

Surveyed Aug. 27, 1970, by L. E. Gould