


T. 15 S. R. 5 W. W. M.

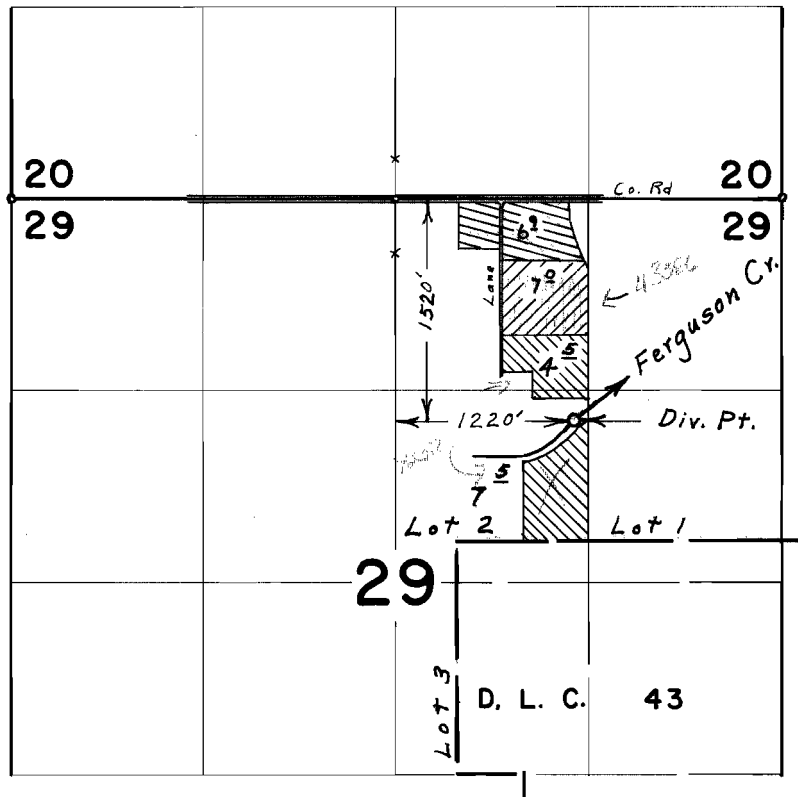

FINAL PROOF SURVEY

UNDER

Transfer No. 2644
43886 32806
 Application No. 42278 Permit No. 31621
 IN NAME OF

JERRY H. MOFFETT

Surveyed Aug. 28, 1970, by L. E. Gould
SEPT. 23, 1974 L. TOLL