


T. 15 S. R. 5 W. W. M.

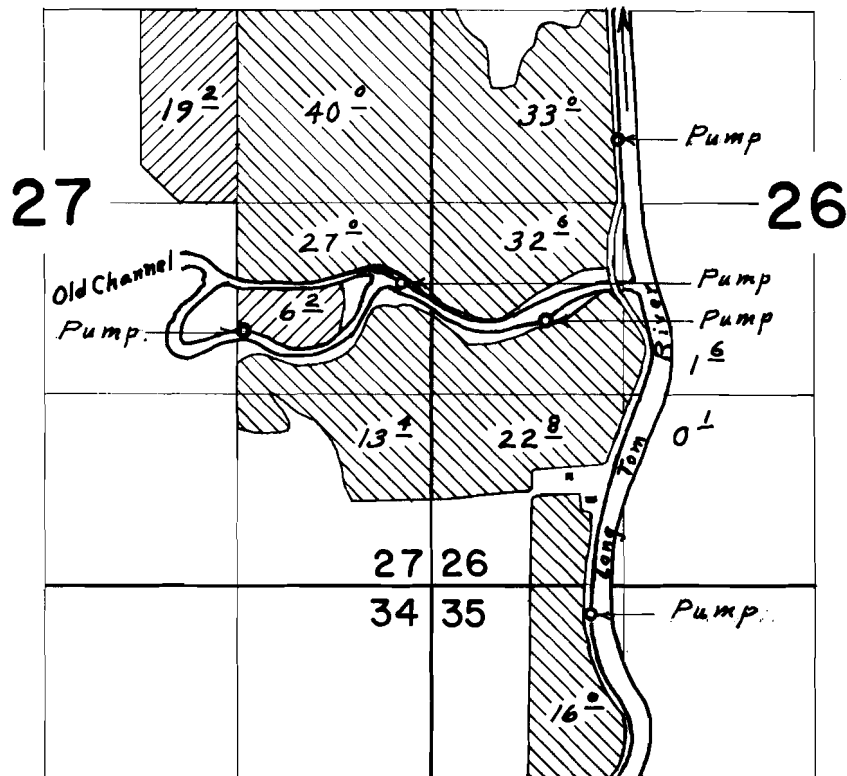


Pumps located: 3070' N. & 1280' E., 1830' N. & 780' E., 2080' N. & 20' W., 1750' N. & 1300' W., 200' S. & 1100' E. all from S. W. Cor. Section 26

Primary



Supplemental

 

FINAL PROOF SURVEY UNDER

Application No. 45712 Permit No. 34118
IN NAME OF

BROCKNER & ARLENE R. MIKKELSEN

Surveyed Aug. 27, 1970, by L. E. Gould