


# T.I.S.R.2W.W.M.

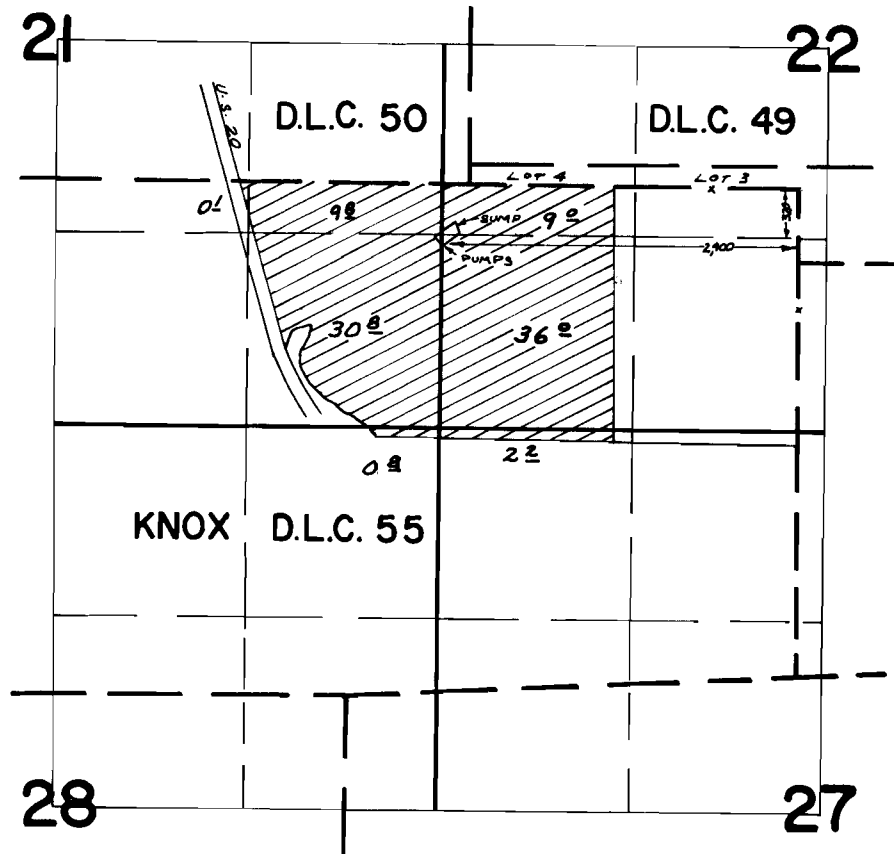

## FINAL PROOF SURVEY UNDER

Application No. G-2823 Permit No. G-2626  
IN NAME OF

JAMES W. OR MARIE T. HICKEY

Surveyed JULY 3, 1969, by W. RUPPERT  
SEPT. 10, 1971 R. MUCKEN