


T. 12 S. R. 2 W. W. M.

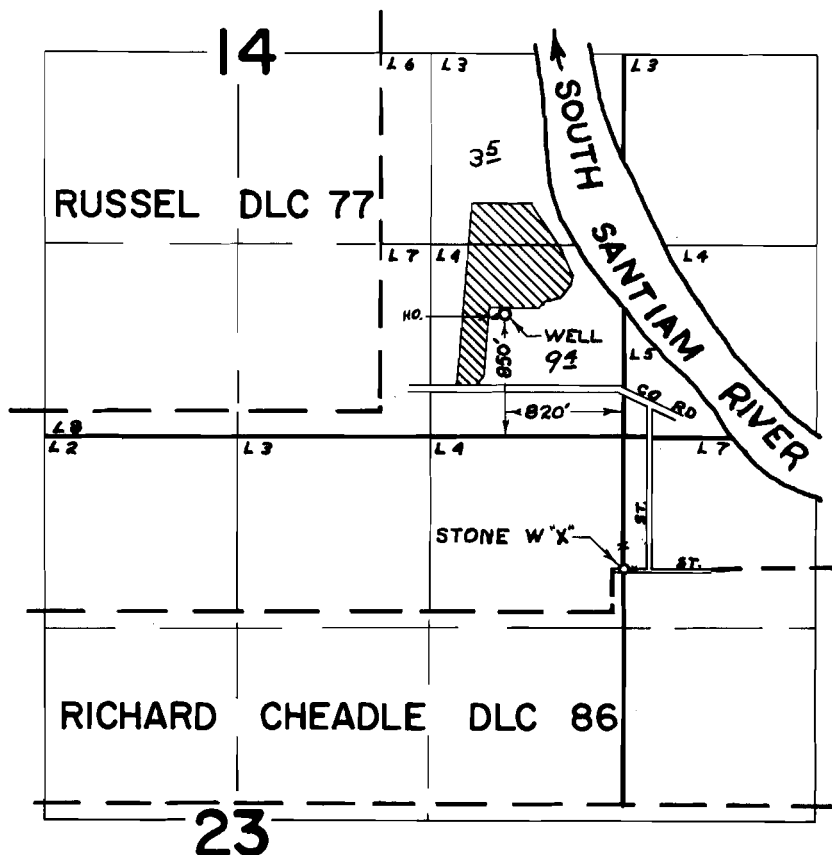

FINAL PROOF SURVEY
UNDER

Application No. G-4476 Permit No. G-4218
IN NAME OF

WILLIAM S. & NELITA N. ELLIS

Surveyed SEP. 8, 1971, by R. MUCKEN