


T. 10S. R. 1W. W.M.

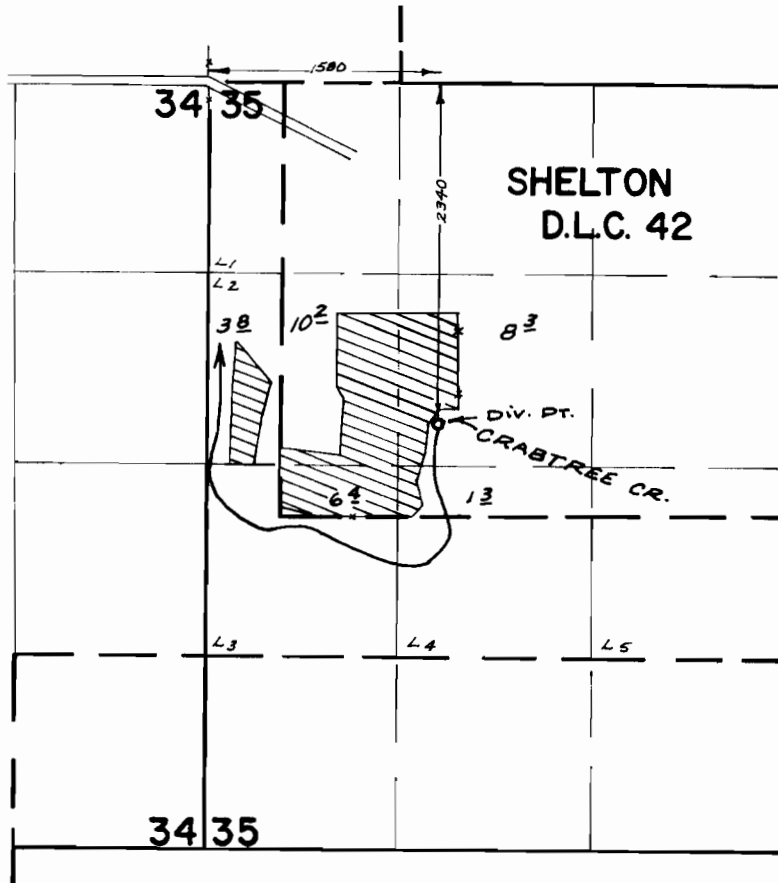

FINAL PROOF SURVEY
UNDER

Application No. 41247 Permit No. 30758
IN NAME OF

E. W. & MARY CAWTHRON

Surveyed MAR. 31, 1970, by B. MUGGEN.