


T. 13 S. R. 1 E. W.M.

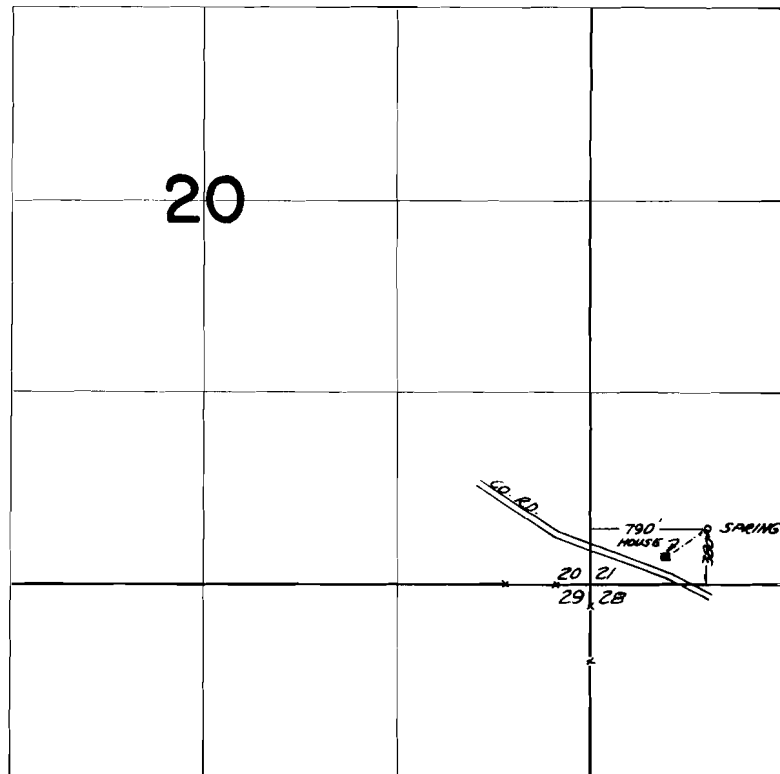

FINAL PROOF SURVEY
UNDER

Application No. 45187 Permit No. 33759
IN NAME OF

PAUL M. and CLARA HOWES

Surveyed May 25 1972, by R.S. Mucken