


T. 6 S. R. 2 W. W. M.

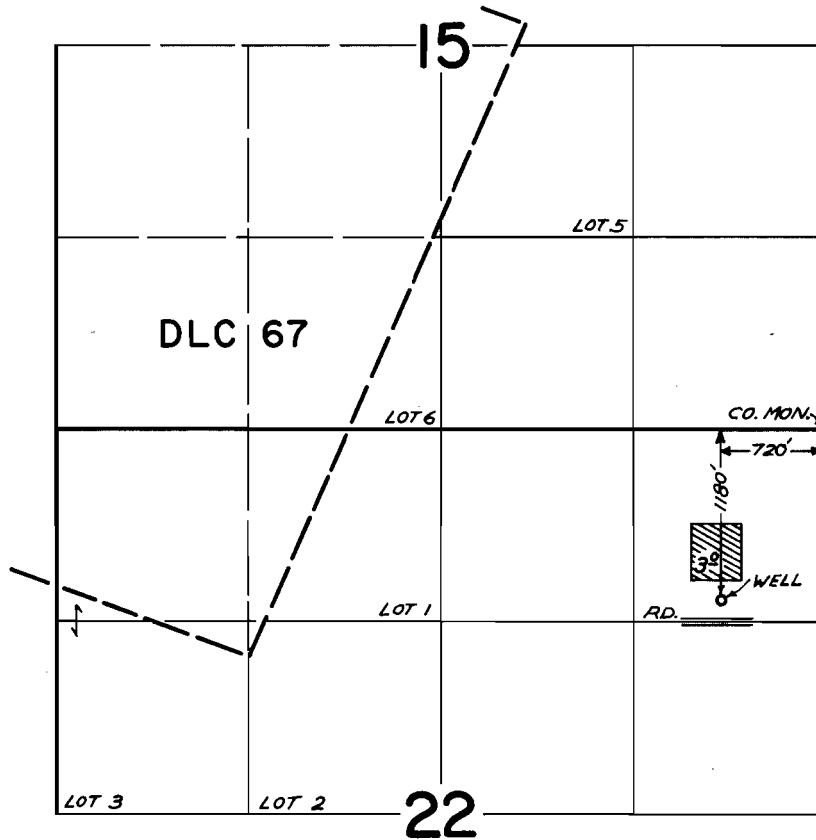

FINAL PROOF SURVEY
UNDER

Application No. G-3587 Permit No. G-3376
IN NAME OF

LAWRENCE EDWARD & ELAINE A. BISBEE

Surveyed JUNE 4 1971, by GREG BACA