


# T.1N.R26E.W.M.

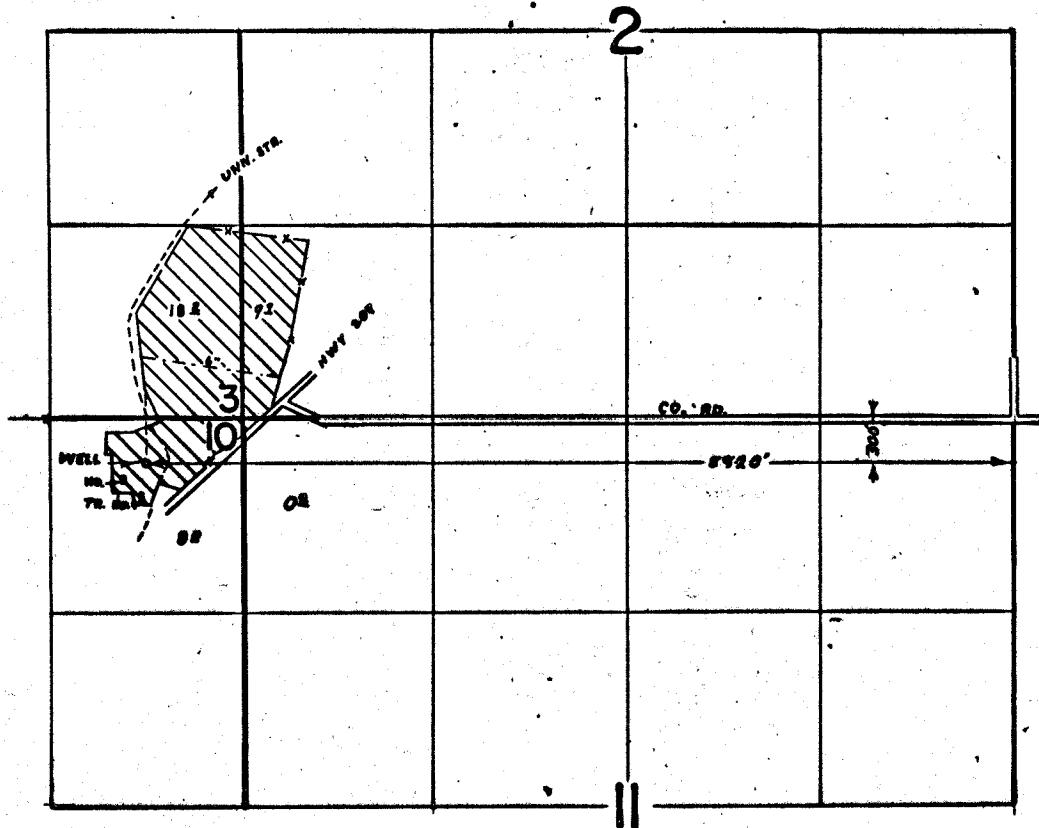

## FINAL PROOF SURVEY UNDER

Application No. G-3841 Permit No. G-3474  
IN NAME OF

WILLIAM J. DOHERTY

Surveyed JUNE 23, 1971., by R. MUCKEN