


T 5 N. R. 26 E. W. M.

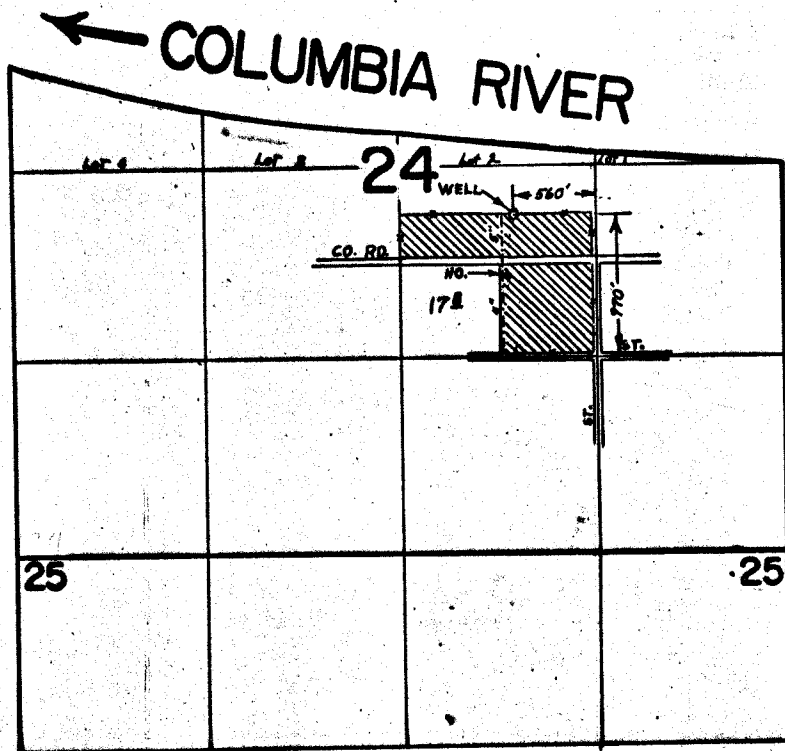

FINAL PROOF SURVEY UNDER

Application No. G-4710... Permit No. G-4474...
IN NAME OF

CHARLES J. & ESTHER E. SWIFT

Surveyed JULY 1, 1971, by R. MUCKEN