


T. 1 S. R. 3 E. W. M.

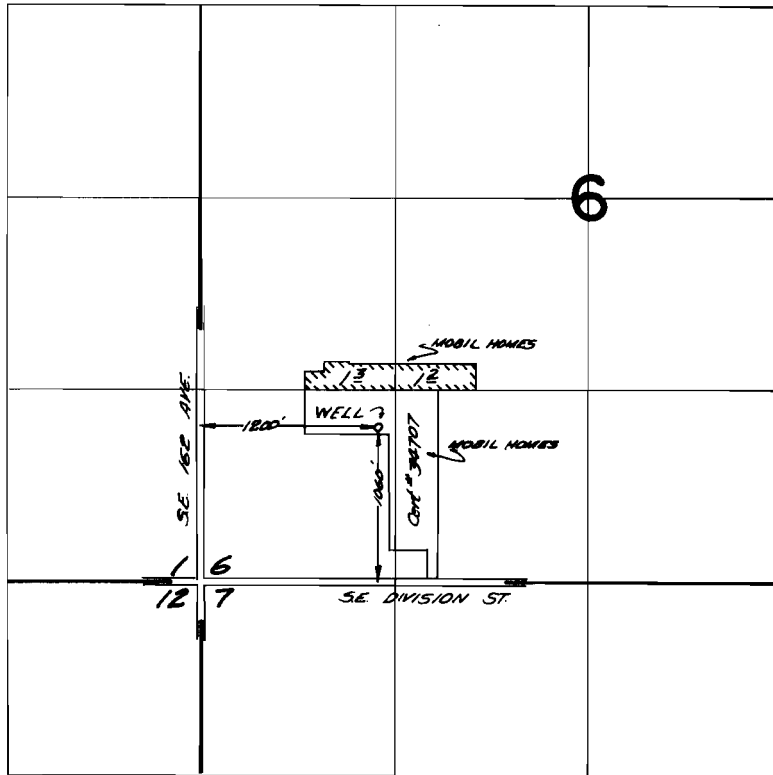

FINAL PROOF SURVEY UNDER

Application No. G-3660 Permit No. G-3452
IN NAME OF

MOBILE ESTATES CORPORATION

Surveyed May 28 1971, by R. S. Mucken

Chief L.D. Jarry *LD*