


T. 5 S. R 11 W. W. M.

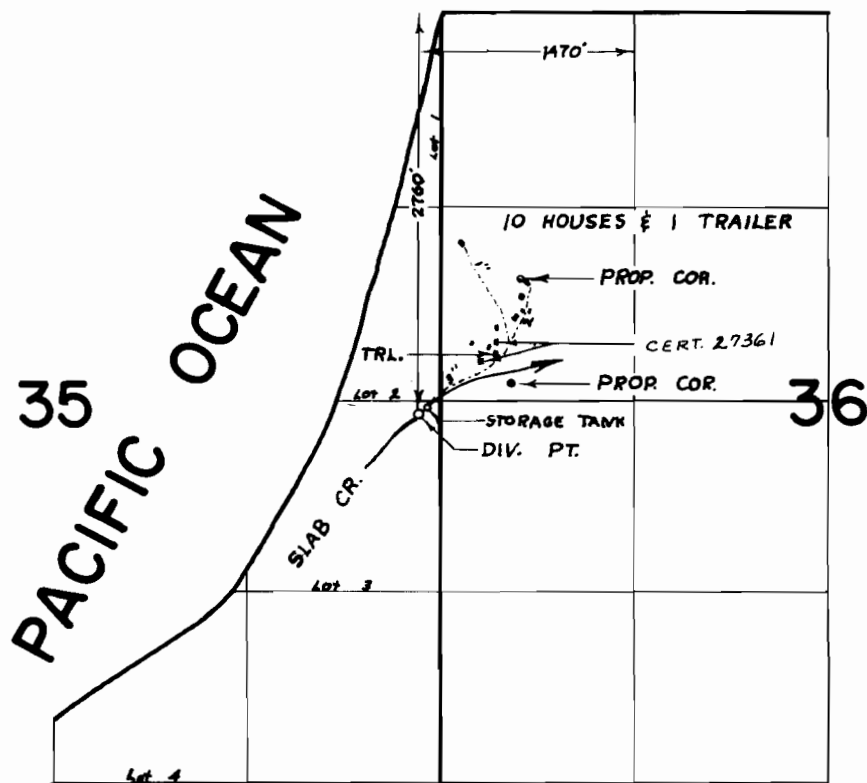

FINAL PROOF SURVEY

UNDER

Application No. 34132 Permit No. 26898
IN NAME OF

SOUTH BEACH WATER CORPORATION

Surveyed AUG.10., 1971., by R....MUCKEN.....