


T 3 S. R. 10 W. W. M.

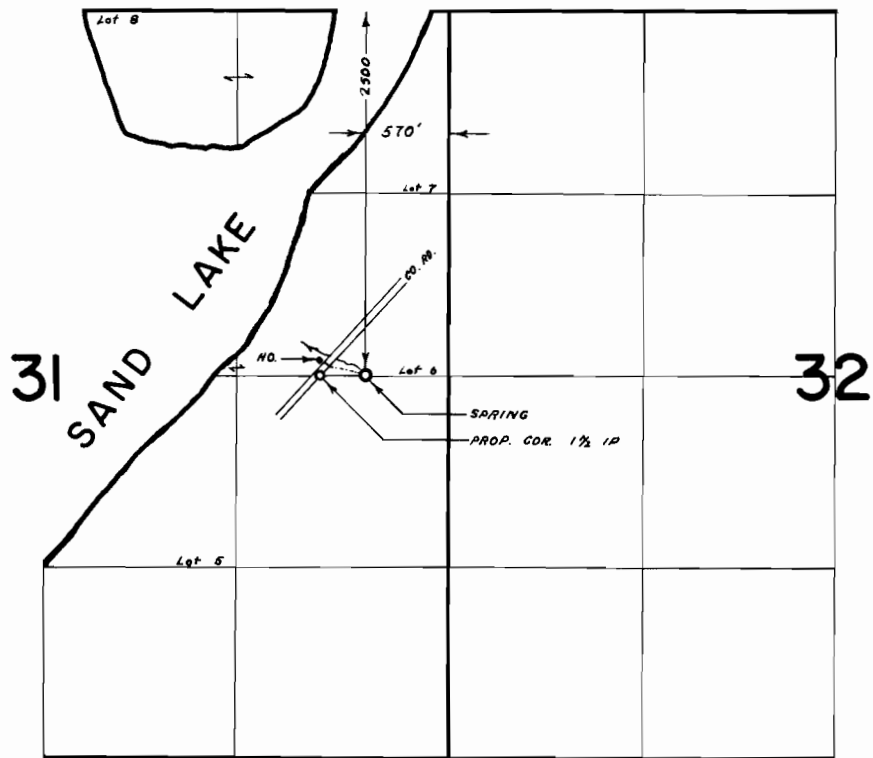

FINAL PROOF SURVEY
UNDER

Application No. 44934... Permit No. 33204...
IN NAME OF

RODNEY C. & PATRICIA L. ANDERSEN

Surveyed AUG. 9... 1971., by R. MUCKEN.....