


T. 4 S. R. 10 W. W. M.:

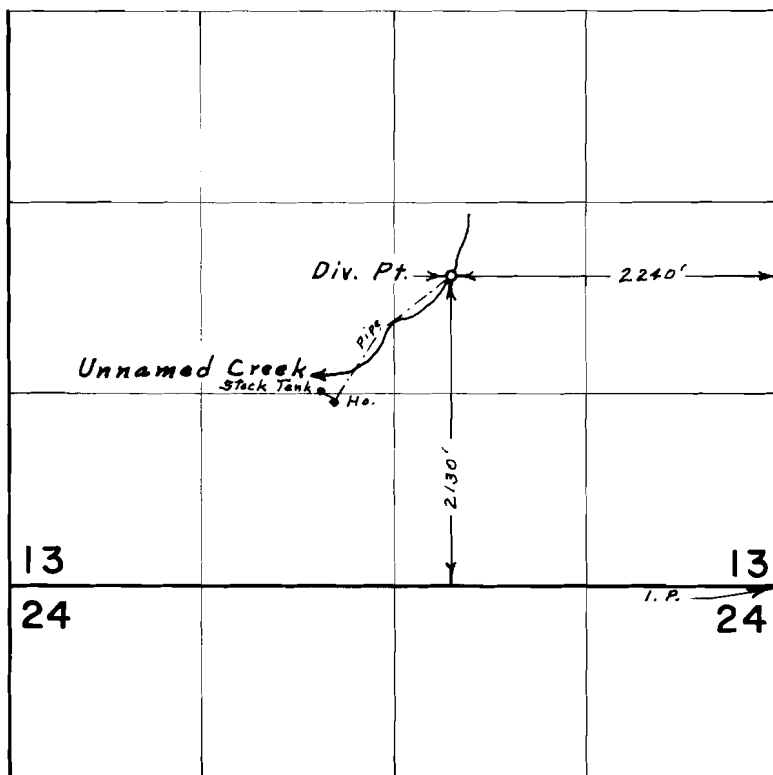

**FINAL PROOF SURVEY**  
UNDER

Application No. 46215 Permit No. 34530  
IN NAME OF

MRS. MARIE L. SHULTZ

Surveyed Aug. 10, 1971, by L. E. Gould