


G-1359
38479

T.5N.R.35E.W.M.

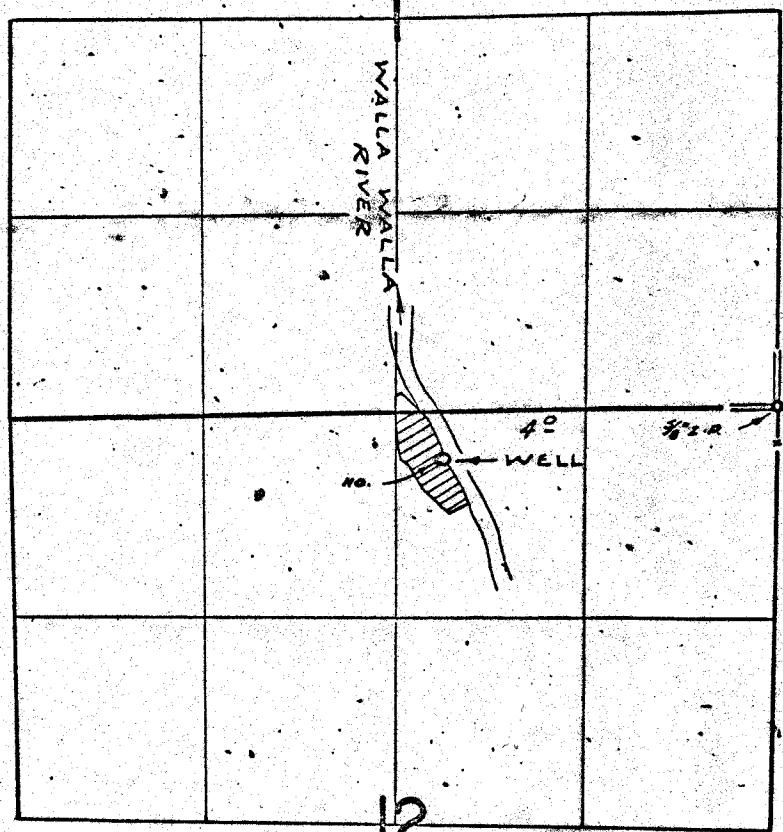

WELL LOC: 300' S. & 2240' W. FROM N.E. COR. SEC. 12

FINAL PROOF SURVEY UNDER

Application No. G-1487 Permit No. G-1359
IN NAME OF

BURLIS & EDNA COPELAND

Surveyed OCT. 26, 1966 by V. GARNER
AUG. 28, 1971, by G. BAGA

R.G.M.