


T. 1 S. R. 32 E. W. M.

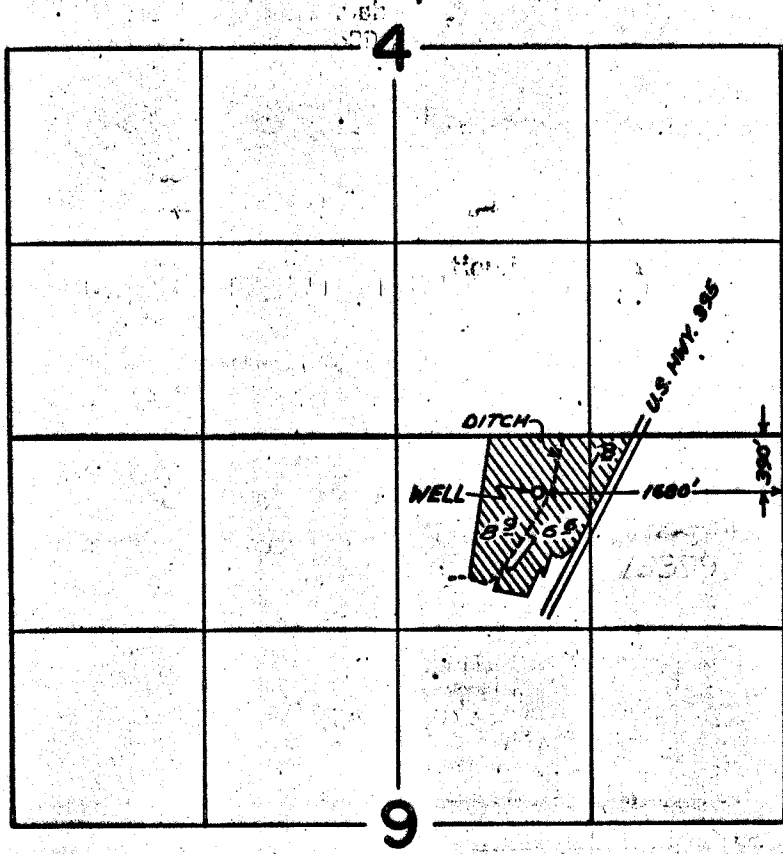

FINAL PROOF SURVEY UNDER

Application No. G-3098 Permit No. G-2955
IN NAME OF

M. N. & MYRTLE E. MARKLE

Surveyed JUNE 30, 1971, by GREG BACA